


APPENDIX C
SETTLEMENT PLOTS

DRAWING NUMBER 86-060-B298
 12-30-89
 12-30-89
 M.J.Y.
 D.H.G.
 10-24-89
 R.H.
 DRAWN BY

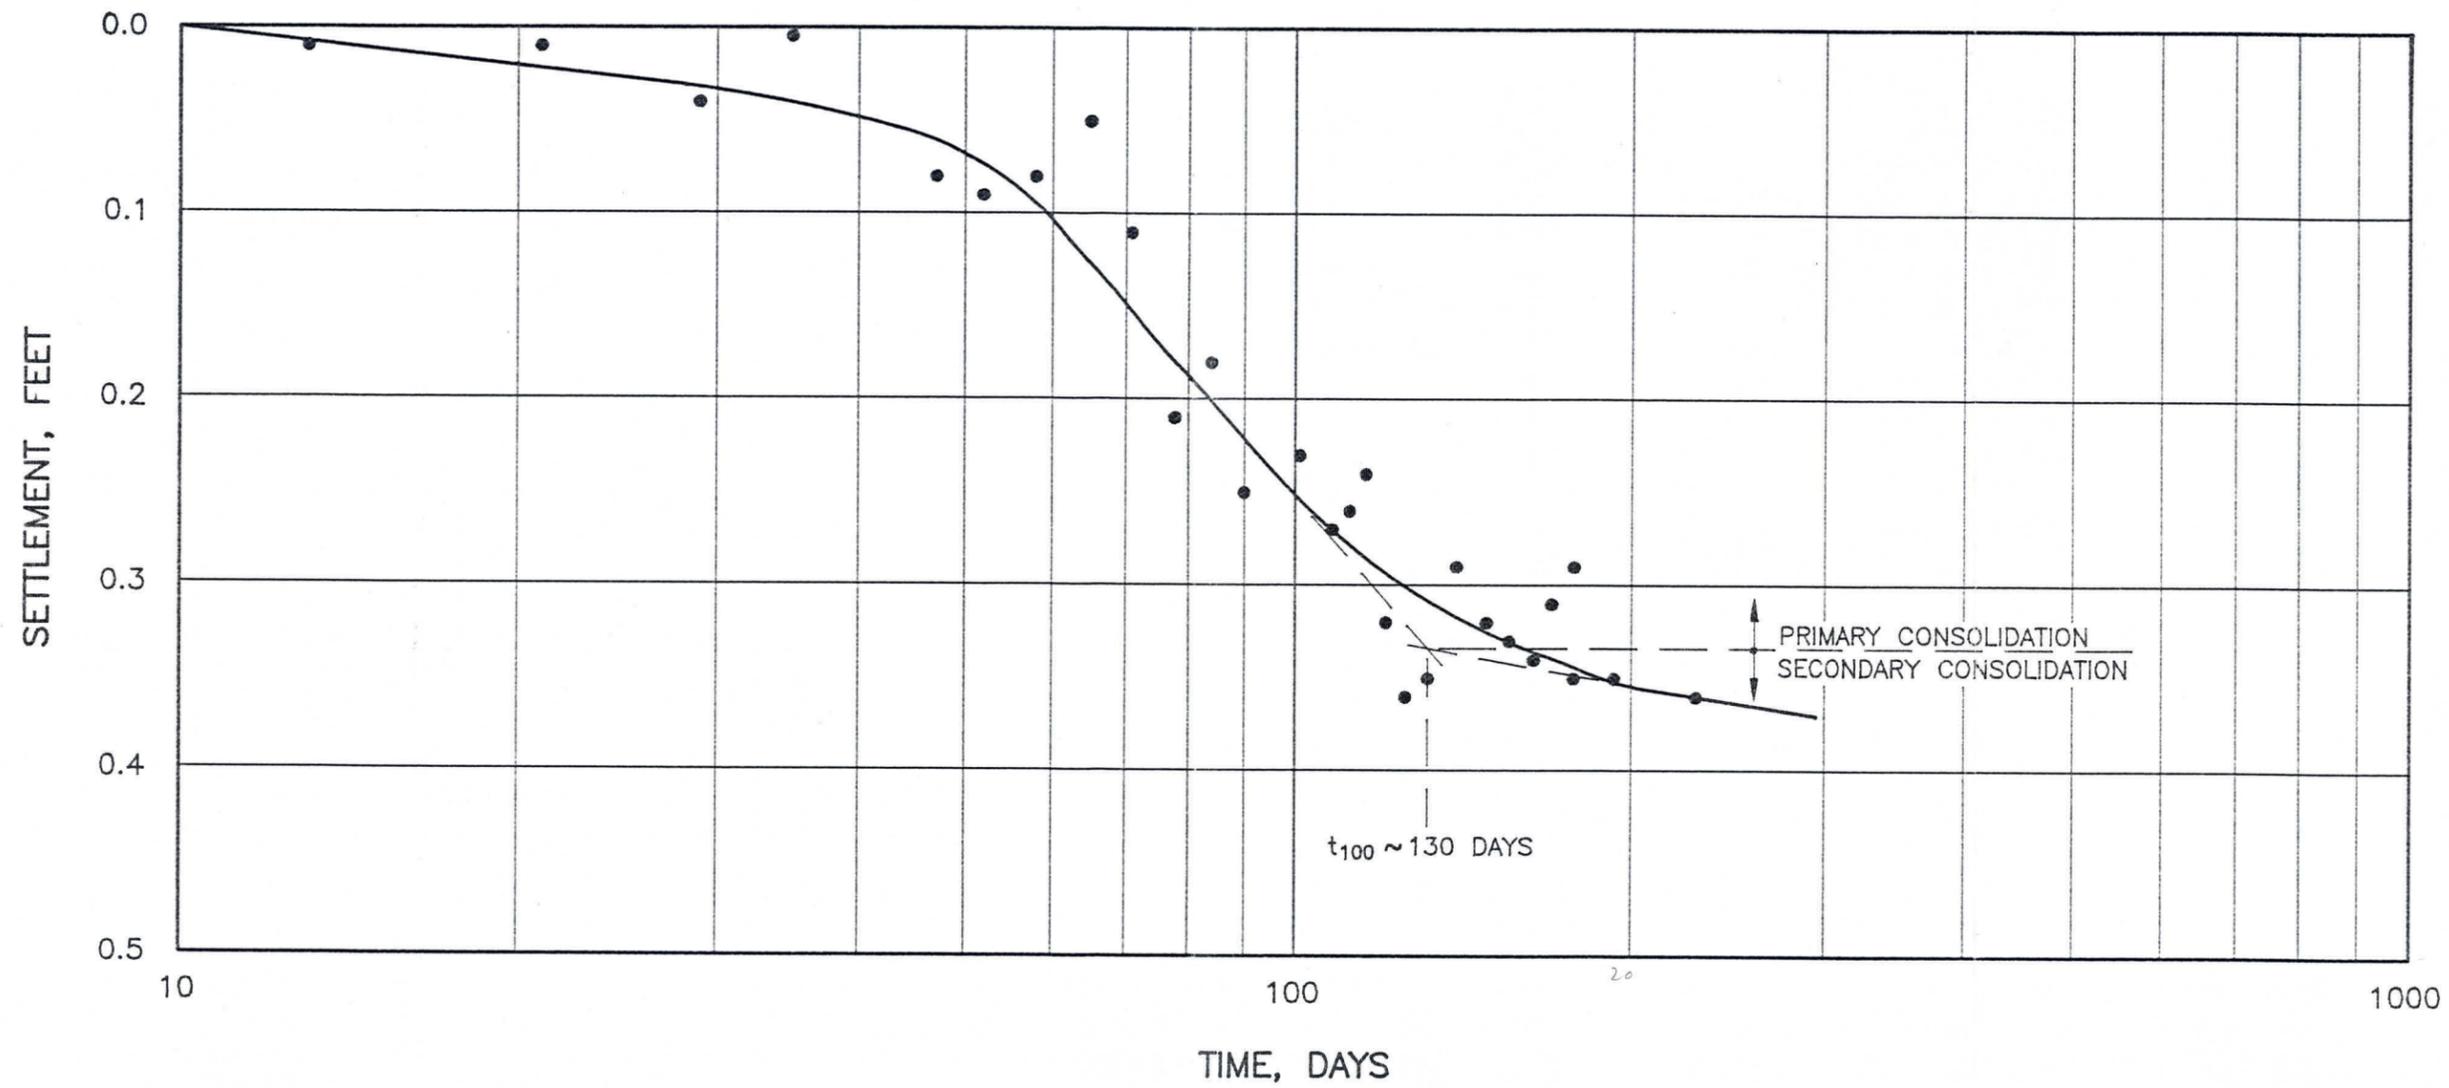

SETTLEMENT VS. LOG TIME
 FOR SM-8
 NORTH CELL TAILINGS
 DISPOSAL FACILITY

PREPARED FOR

UNC MINING AND MILLING
 GALLUP, NEW MEXICO

LEGEND:
 t_{100} TIME TO END OF PRIMARY
 CONSOLIDATION

△	1-26-90	UPDATE FOR FINAL NORTH CELL AS-BUILT REPORT	M.B.H.	opw	
△	12-30-89	UPDATE FOR AS-BUILT REPORT SUBMITTAL	M.B.H.	M.J.Y. D.H.G.	
No.	DATE	ISSUE / REVISION	OWN. BY	CK'D BY	AP'D BY

Canonie Environmental

DATE: 10-24-89
 SCALE: AS SHOWN
 FIGURE C-1
 DRAWING NUMBER 86-060-B298

DRAWING NUMBER 86-060-B300


12-30-89
12-30-89

M.J.Y.
D.H.G.

CHECKED BY
APPROVED BY

R.H.
10-31-89

DRAWN BY

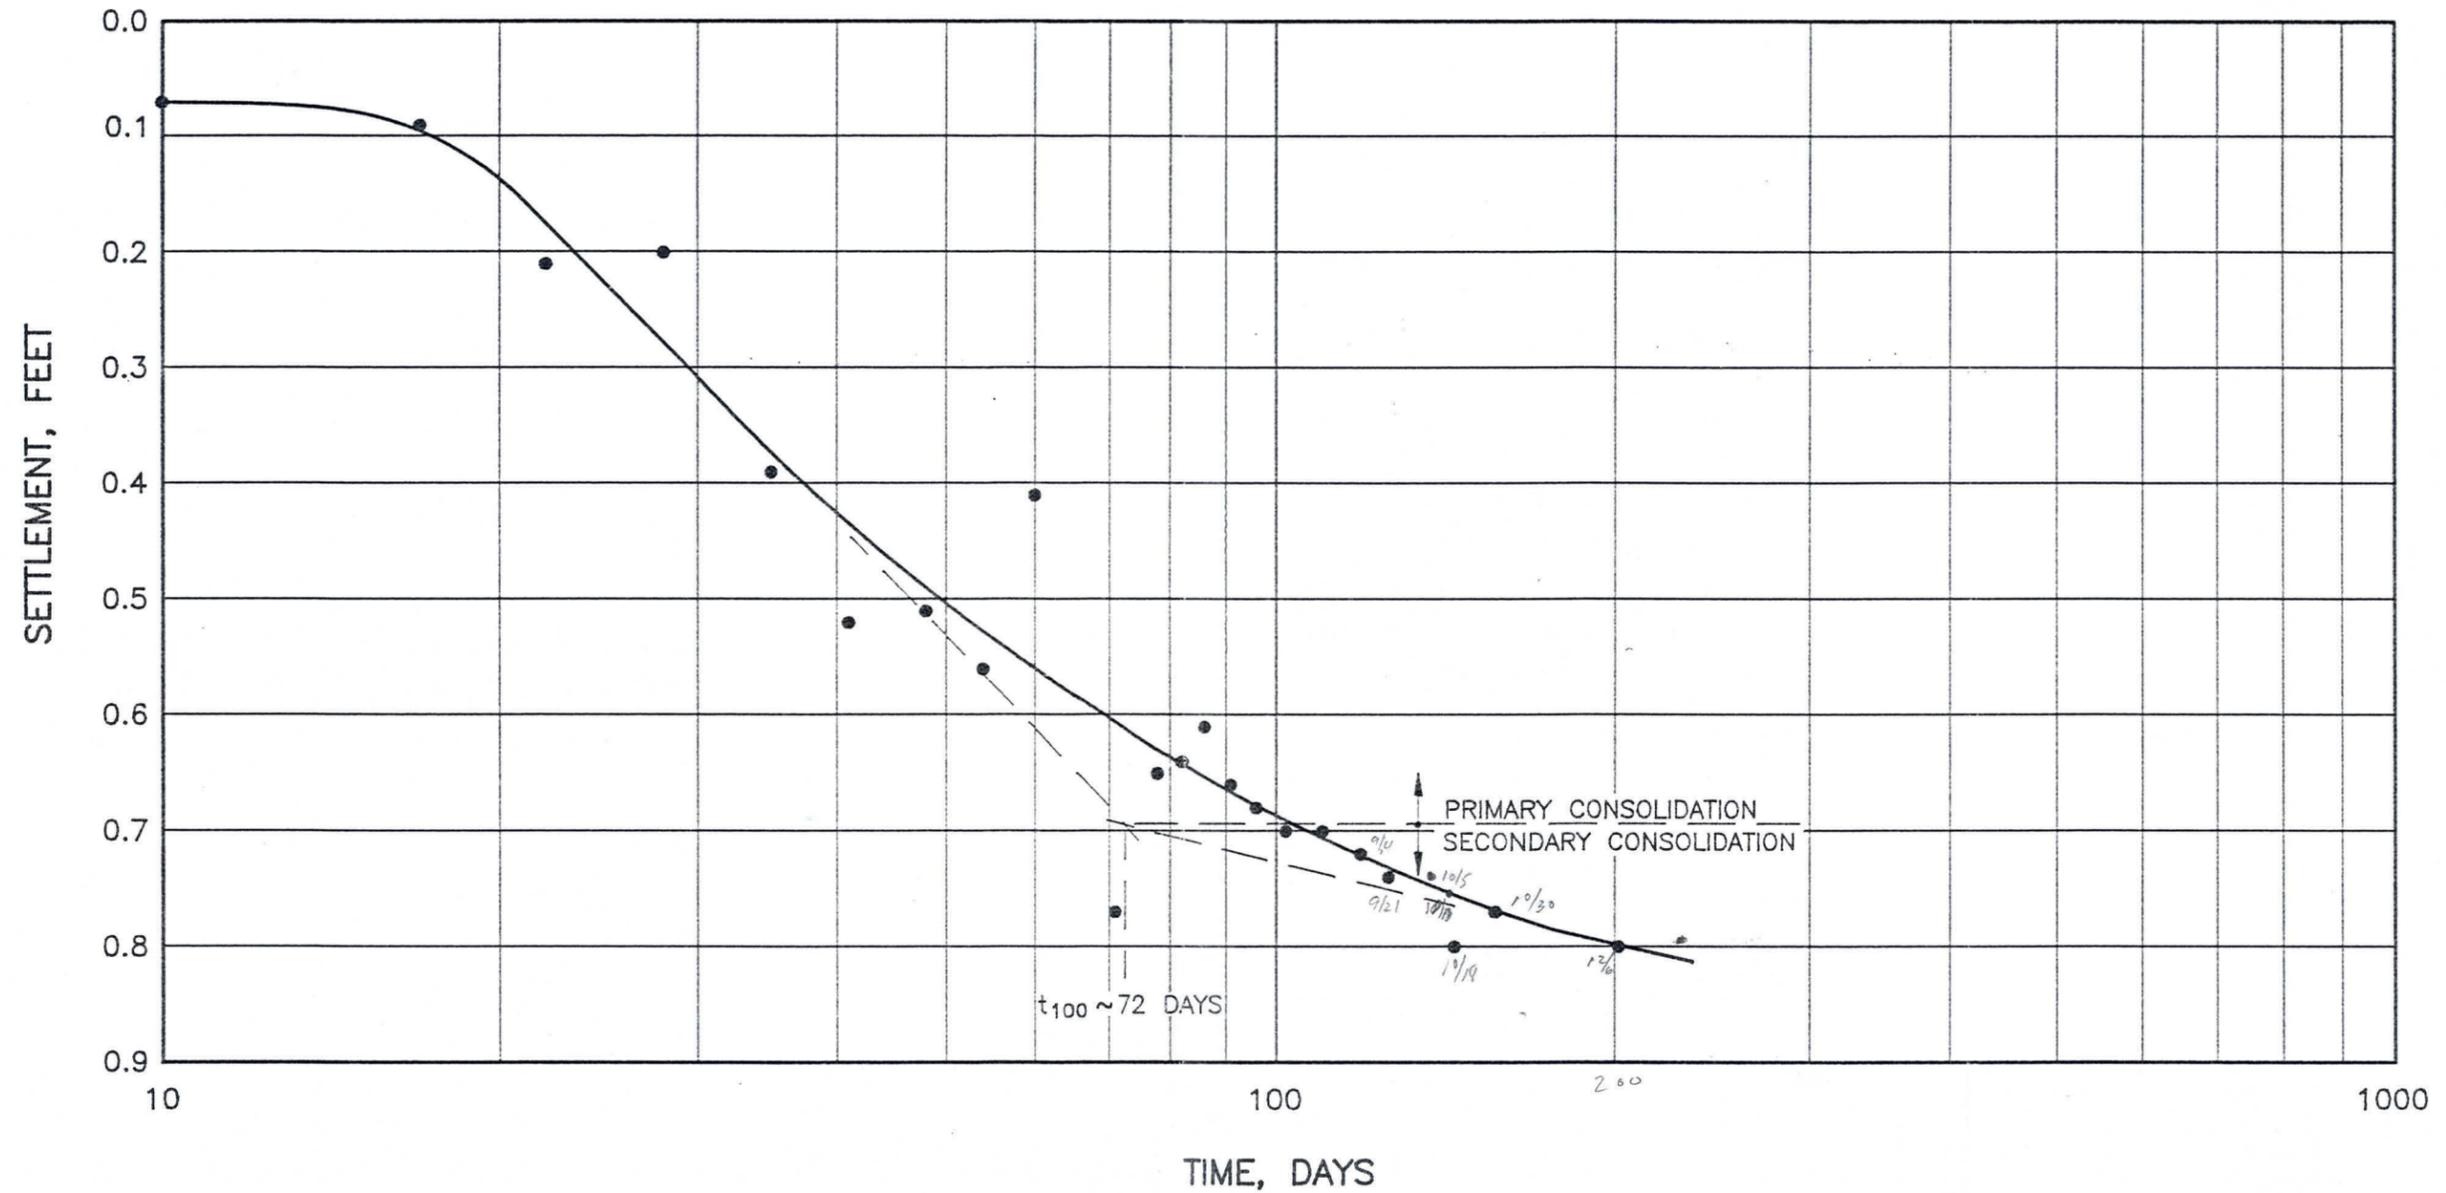

SETTLEMENT VS. LOG TIME
FOR SM-9
NORTH CELL TAILINGS
DISPOSAL FACILITY

PREPARED FOR

UNC MINING AND MILLING
GALLUP, NEW MEXICO

CanonieEnvironmental


LEGEND:

t_{100} TIME TO END OF PRIMARY
CONSOLIDATION

No.	DATE	ISSUE / REVISION	OWN.	BY	CK'D BY	AP'D BY
1	1-26-90	UPDATE FOR FINAL NORTH CELL AS-BUILT REPORT	M.B.H.	mjj	opw	
2	12-30-89	UPDATE FOR AS-BUILT REPORT SUBMITTAL	M.B.H.	M.J.Y.	D.H.G.	

DATE: 10-31-89
SCALE: AS SHOWN
FIGURE C-2
DRAWING NUMBER 86-060-B300

DRAWING NUMBER 86-060-B301
 12-30-89 12-30-89
 M.J.Y. D.H.G.
 CHECKED BY APPROVED BY
 10-31-89
 R.H.
 DRAWN BY

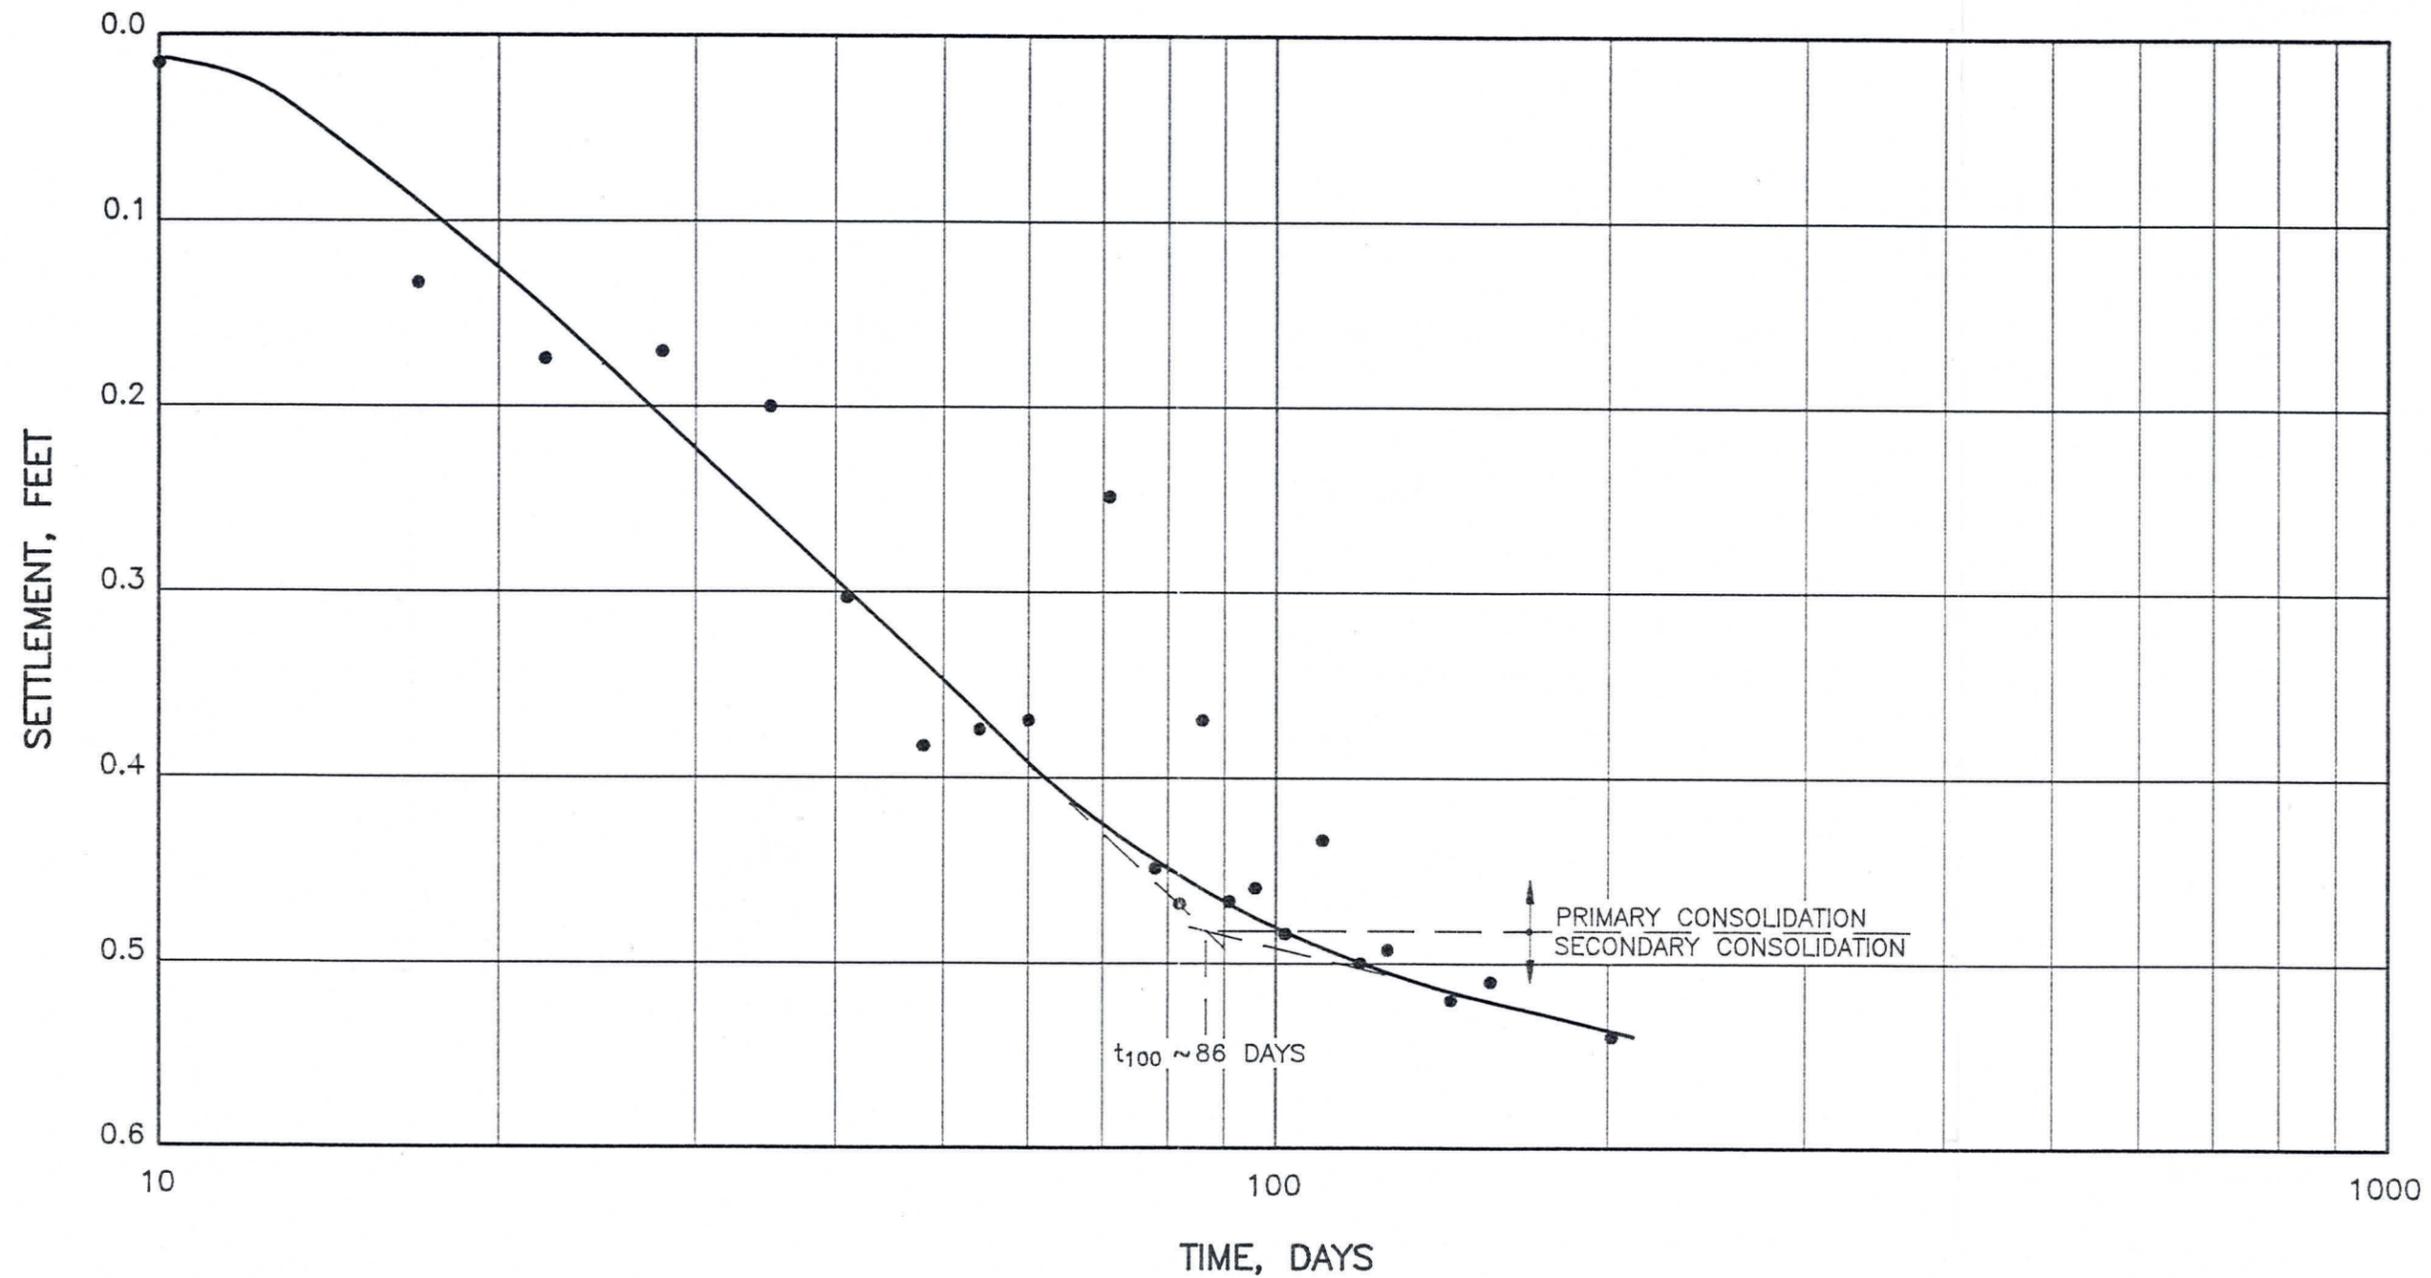

SETTLEMENT VS. LOG TIME
 FOR SM-10
 NORTH CELL TAILINGS
 DISPOSAL FACILITY

PREPARED FOR

UNC MINING AND MILLING
 GALLUP, NEW MEXICO

LEGEND:
 t_{100} TIME TO END OF PRIMARY
 CONSOLIDATION

CanonieEnvironmental

No.	DATE	ISSUE / REVISION	DWN. BY	CK'D BY	AP'D BY
1	1-26-90	UPDATE FOR FINAL NORTH CELL AS-BUILT REPORT	M.B.H.	<i>mjj</i>	<i>opw</i>
2	12-30-89	UPDATE FOR AS-BUILT REPORT SUBMITTAL	M.B.H.	M.J.Y.	D.H.G.

DATE: 10-31-89
 SCALE: AS SHOWN
 FIGURE C-3
 DRAWING NUMBER 86-060-B301