




FILTER MONITOR PANEL - SOUTH PLANT
NO SCALE

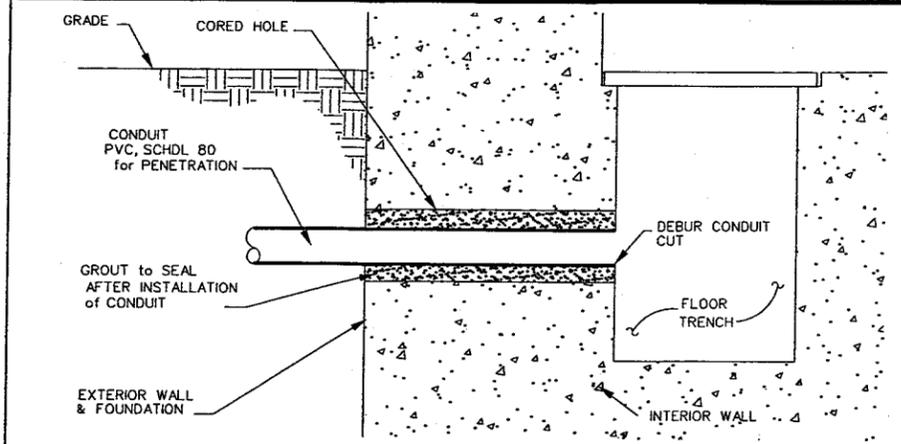


DETAIL 1
BLOCK/CONCRETE WALL CONDUIT PENETRATION - WATERMAN
FOR EXTERIOR to INTERIOR PENETRATIONS

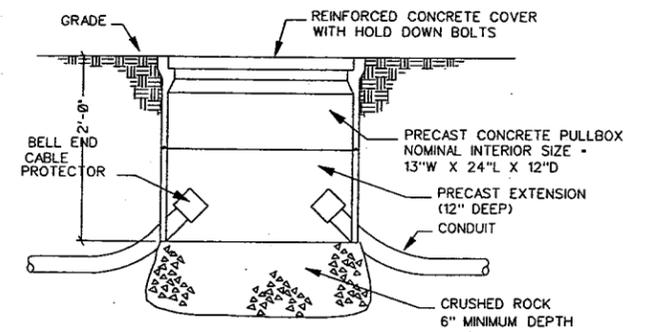


DETAIL 4 - PRECAST PULLBOX

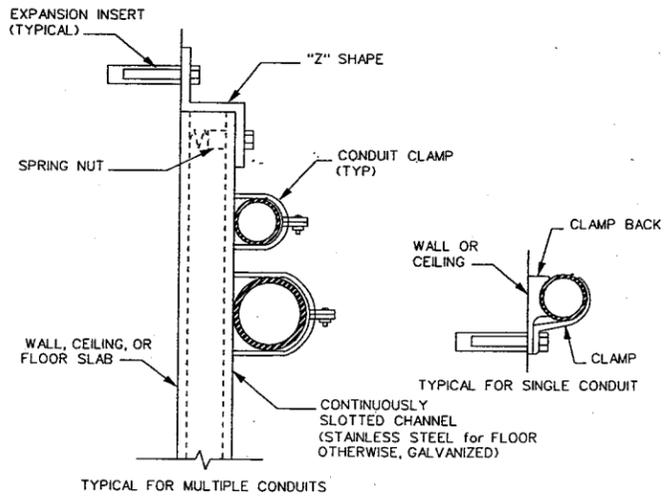


DETAIL 2 - CONDUIT SUPPORTS

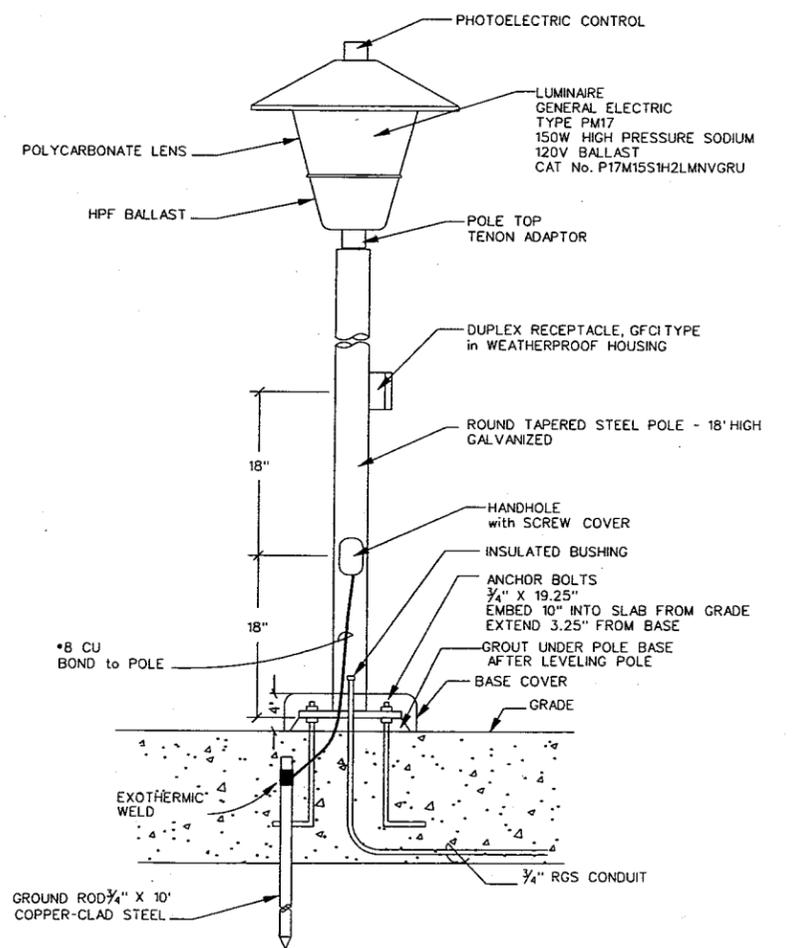

DETAIL 5 - AREA LIGHT POLE
"RECORD DRAWING"

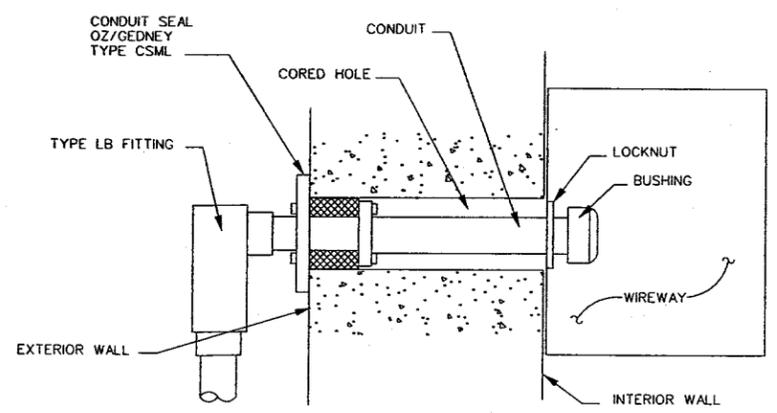

DETAIL 6
BLOCK/CONCRETE WALL CONDUIT PENETRATION
FOR EXTERIOR to INTERIOR PENETRATIONS

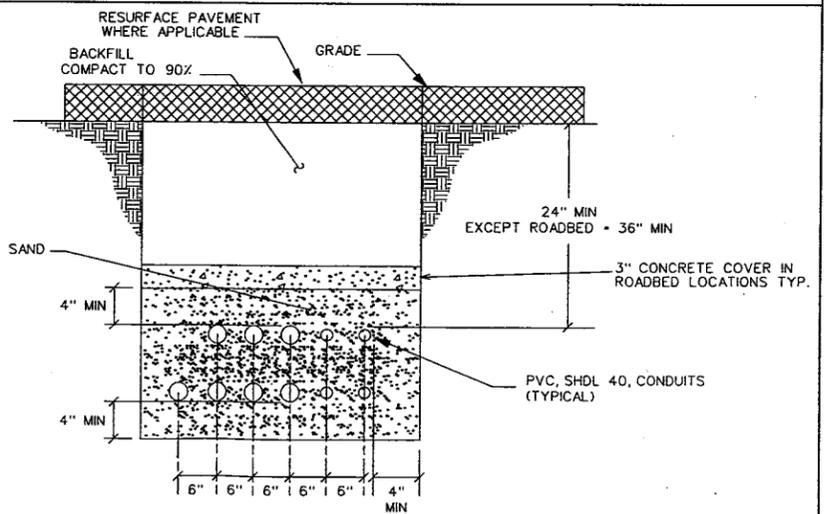

DETAIL 3 - DUCTBANK

T:\USTS\PROJ\NEWMAP\ASBUILT\ E-6.DGN

NO.	DATE	DESCRIPTION	NO.	DATE	DESCRIPTION
1	11/98	RECORD DRAWING			
REVISIONS					

DESIGNED BY:
DRAWN BY:
CHECKED BY:

URS URS Consultants, Inc.
CONSULTING ENGINEERS
SACRAMENTO CALIFORNIA


JOB No. 62370.60.30





NEWMARK OU REMEDIAL DESIGN
NEWMARK GROUNDWATER
CONTAMINATION SUPERFUND SITE
NORTH & SOUTH PLANTS

ELECTRICAL DETAILS

SCALE: NONE Date: 3/97 Dwg. No.: E-6

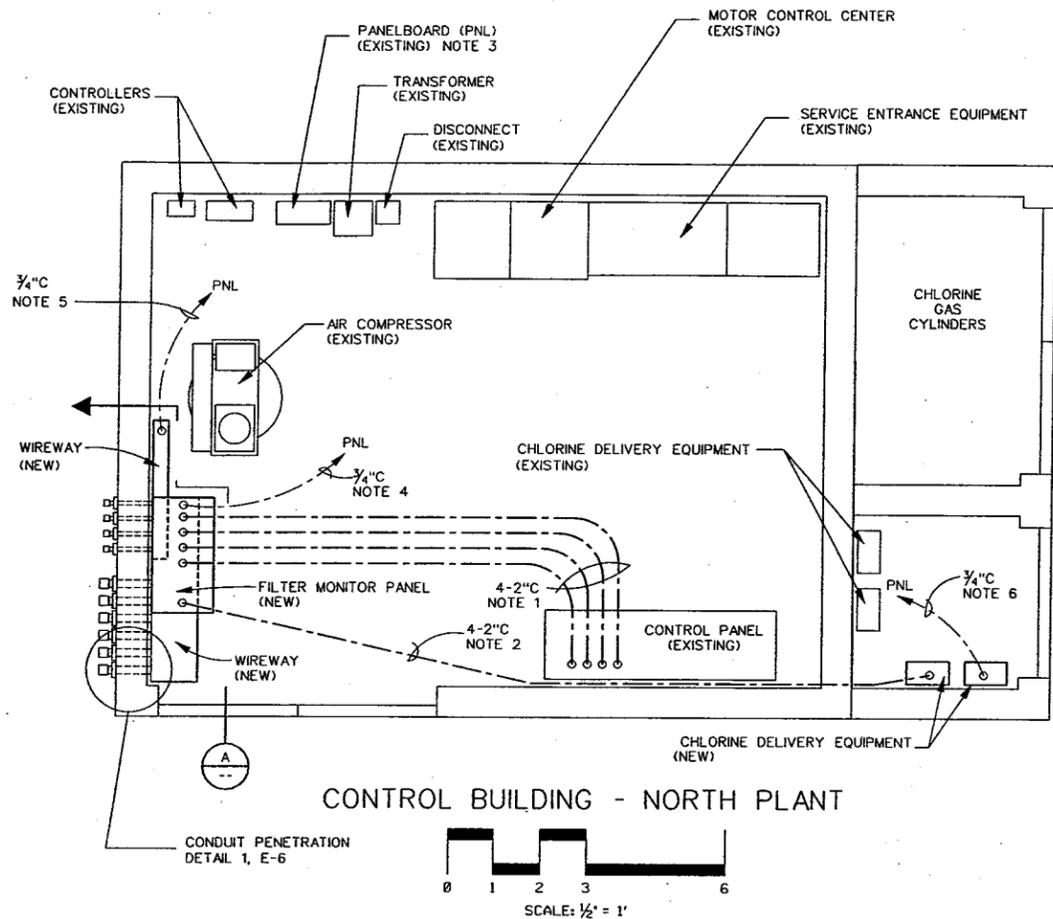

CONTROL BUILDING - NORTH PLANT

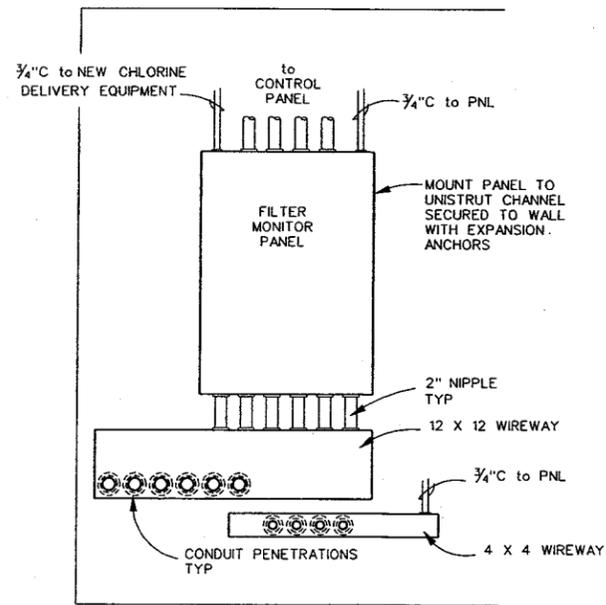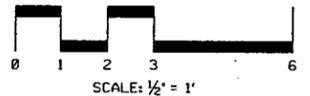

SECTION A - FILTER MONITOR PANEL
NO SCALE

CONTROL BUILDING NOTES:

1. INSTALL 4 - 2" C FROM FILTER MONITOR PANEL TO EXISTING CONTROL PANEL. INSTALL 22-2P*20 IS/O5 CABLES. CONNECT CABLE ENDS AT FILTER MONITOR PANEL TO INTERFACE "SCADA" TERMINALS. PROVIDE UNIQUE WIRE MARKERS FOR EACH WIRE INSTALLED ON BOTH ENDS OF CABLE. EXTEND CABLES INTO EXISTING CONTROL PANEL 10' AND COIL FOR FUTURE USE BY DISTRICT.
2. INSTALL 3/4" CONDUIT FROM FILTER MONITOR PANEL TO NEW CHLORINE DELIVERY EQUIPMENT. ROUTE 1P*20, SH CABLE FROM APPLICABLE SIGNAL ISOLATOR FOR TOTAL FLOW SIGNAL FOR USE BY CHLORINE DELIVERY EQUIPMENT.
3. MODIFY EXISTING PANELBOARD. ADD FOUR NEW SINGLE-POLE, 20A BREAKERS TO BE CONNECTED TO FOLLOWING NEW LOADS:
 - FILTER MONITOR PANEL
 - FILTER RUPTURE MONITORS
 - FILTER AREA LIGHTING and RECEPTACLES
 - NEW CHLORINE DELIVERY EQUIPMENT
4. INSTALL 3/4" CONDUIT FROM PANELBOARD TO FILTER MONITOR PANEL. ROUTE AND CONNECT 2*12 & *12G FOR NEW BRANCH CIRCUIT FOR FILTER MONITOR PANEL.
5. INSTALL 3/4" CONDUIT FROM PANELBOARD TO 4" X 4" WIREWAY. ROUTE AND CONNECT 2*12 & *12G FOR NEW BRANCH CIRCUIT TO ALL RUPTURE MONITOR PANELS. ROUTE AND CONNECT 2*10 & *10G FOR NEW BRANCH CIRCUIT TO AREA LIGHTING AND RECEPTACLES.
6. INSTALL 3/4" CONDUIT FROM PANELBOARD TO NEW CHLORINE DELIVERY EQUIPMENT. ROUTE AND CONNECT 2*12 & *12G FOR NEW BRANCH CIRCUIT FOR NEW CHLORINE DELIVERY EQUIPMENT.

"RECORD DRAWING"


T:\AUSTIN\PROJ\NEWMARK\BUILTY E-7.DGN

NO.	DATE	DESCRIPTION	NO.	DATE	DESCRIPTION
1/98		RECORD DRAWING			
REVISIONS					

DESIGNED BY: _____
 DRAWN BY: _____
 CHECKED BY: _____

URS URS Consultants, Inc.
 CONSULTING ENGINEERS
 SACRAMENTO CALIFORNIA

JOB No. _____

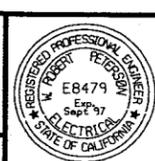

NEWMARK OU REMEDIAL DESIGN
 NEWMARK GROUNDWATER
 CONTAMINATION SUPERFUND SITE
 NORTH & SOUTH PLANTS

CONTROL BUILDING NORTH PLANT	
SCALE: NONE	Date: 3/97
Dwg. No.: E-7	

UNITED STATES ENVIRONMENTAL PROTECTION AGENCY

REGION IX


NEWMARK OU REMEDIAL DESIGN
NEWMARK GROUNDWATER
CONTAMINATION SUPERFUND SITE
17 th STREET PLANT

RECORD DRAWINGS


PREPARED BY
URS CONSULTANTS, INC.
SACRAMENTO, CA

MAY 2001

PIPE LINE SYMBOL IDENTIFICATION

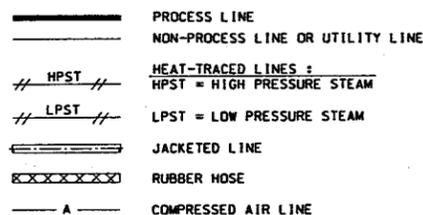


VALVE SYMBOLS

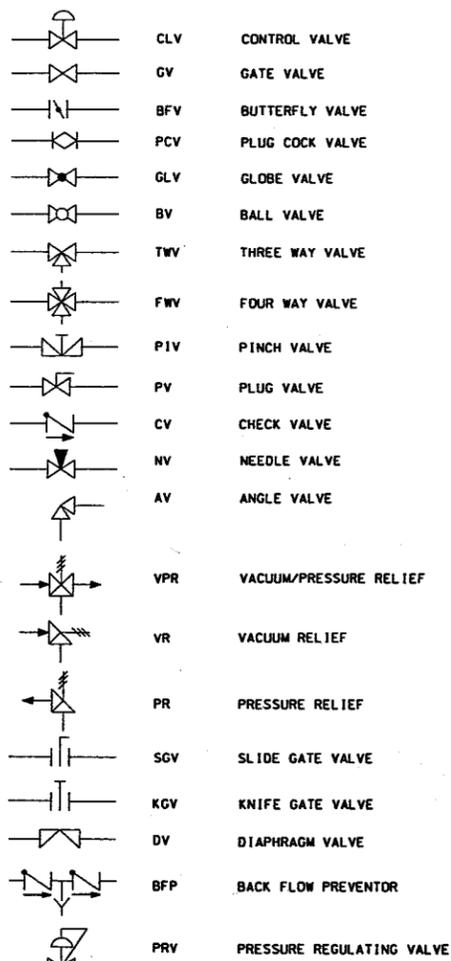


PIPE FITTING SYMBOLS
(USE FOR INSTALLATION OF ALL MATERIALS)




PIPE LINE DESIGNATIONS

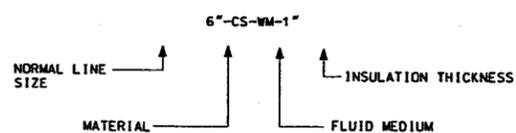

MISCELLANEOUS PIPING COMPONENTS

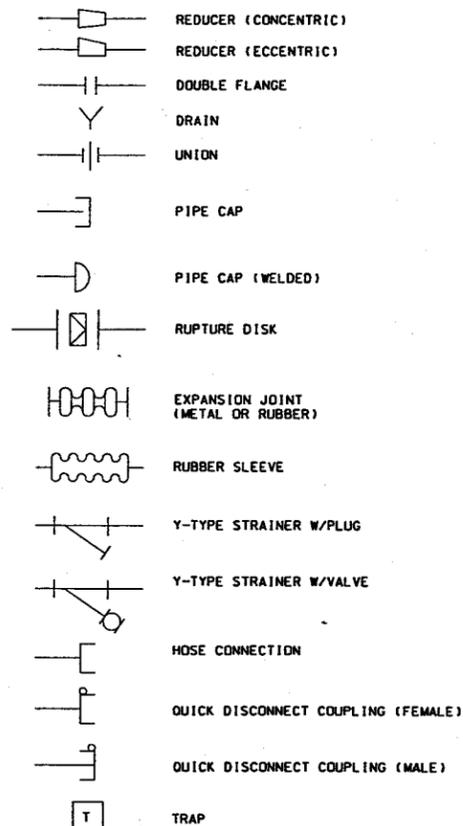

EQUIPMENT DESIGNATIONS

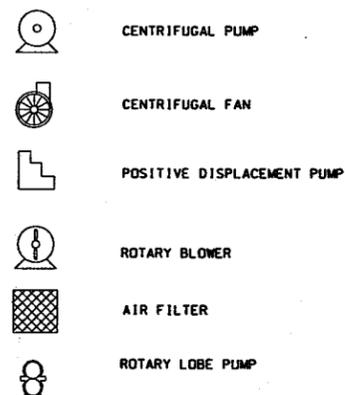

PIPING DESIGNATIONS

- CI - CAST IRON
- CS - CARBON STEEL
- CU - COPPER TUBING
- PVC - POLYVINYL CHLORIDE
- PVCB - POLYVINYL CHLORIDE SCHEDULE 80
- CPVC - CHLORINATED POLYVINYL CHLORIDE
- SS - STAINLESS STEEL
- GCS - GALVANIZED CARBON STEEL
- LCS - LINED CARBON STEEL
- FS - FLEXIBLE HOSE


ABBREVIATIONS

- ATM - ATMOSPHERIC
- BF - BLIND FLANGE
- BOP - BOTTOM OF PIPE
- CW - CHAINWHEEL OPERATED
- DR. - DRAIN
- F - FITTING
- FC - FAIL CLOSED
- FI - FAIL INDETERMINATE
- FO - FAIL OPEN
- GO - GEAR OPERATED
- H.C. - HOSE CONNECTION
- H. PT - HIGH POINT
- IAS - INSTRUMENT AIR SUPPLY
- IAS - INSTRUMENT AIR SUPPLY
- L. PT - LOW POINT
- NC - NORMALLY CLOSED
- NLL - NORMAL LIQUID LEVEL
- NO - NORMALLY OPEN
- P - PIPE
- P.O.S. - POINT OF SUPPORT
- RO - RESTRICTION ORIFICE
- S.T. - SAMPLE TAP
- V - VALVE
- V.S. - VENDOR SUPPLIED ITEM
- XJ - EXPANSION JOINT

FLUID MEDIUM SPECIFICATIONS TABLE

FLUID MEDIUM ABBREVIATIONS	FLUID MEDIUM
RW	RAW WATER
TW	TREATED WATER
BW	BACKWASH WATER
SBW	SPENT BACKWASH WATER

INSTRUMENTATION SYMBOLS & LEGEND

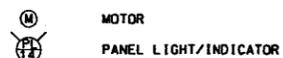


(INSTRUMENTATION)



(EQUIPMENT)



INSTRUMENTATION SYMBOLS & LEGEND continued

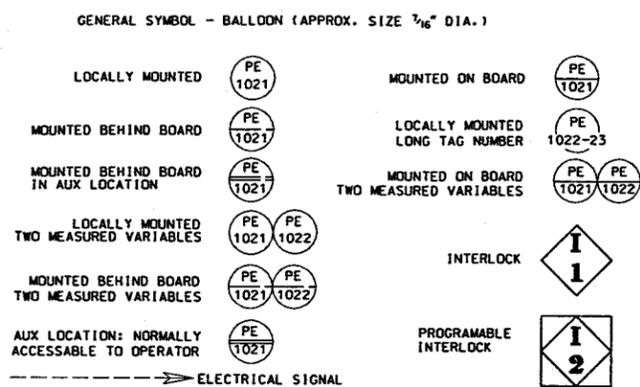



MEANINGS OF IDENTIFICATION LETTERING

LTR	FIRST LETTER		SUCCEEDING LETTER		
	MEASURED OR INITIATING VARIABLE	MODIFIER	READOUT OR PASSIVE FUNCTION	OUTPUT FUNCTION	MODIFIER
A	ANALYSIS	-	ALARM	-	-
B	BURNER FLAME	-	USERS CHOICE	-	-
C	CONDUCTIVITY (ELC)	-	-	CONTROL 13	-
D	DENSITY (MASS) or SPECIFIC GRAVITY	DIFFERENTIAL	-	-	-
E	VOLTAGE (EMF)	-	PRIMARY ELEMENT	-	-
F	FLOW RATE	RATIO (FRACTION)*	-	-	-
G	GAGING (DIMENSIONAL)	-	GLASS*	-	-
H	HAND (MANUALLY ACTIVATED)	-	ALARM	-	HIGH #
I	CURRENT (ELEC)	-	INDICATE	-	-
J	POWER	SCAN	-	-	-
K	TIME OR TIME - SCHEDULE	-	-	CONTROL STATION	-
L	LEVEL	-	LIGHT (PILOT)	-	LOW
M	MOISTURE OR HUMIDITY	-	-	-	MIDDLE OR INTERMEDIATE
N	USERS CHOICE*	-	-	-	-
O	USERS CHOICE*	-	ORIFICE (RESTRICTION)	-	-
P	PRESSURE/VACUUM	-	POINT (TEST CONNECTION)	-	-
Q	QUANTITY/EVENT	INTEGRATE OR TOTALIZE*	-	-	-
R	RADIOACTIVITY	-	RECORD/PRINT	-	-
S	SPEED/FREQUENCY	SAFETY*	-	SWITCH*	-
T	TEMPERATURE	-	ALARM	TRANSMIT	-
U	MULTIVARIABLE*	-	MULTIFUNCTION	-	-
V	VISCOSITY	-	-	VALVE DAMPER OR LOUVER*	-
W	WEIGHT/FORCE	-	WELL	-	-
X	UNCLASSIFIED*	-	-	-	-
Y	USERS CHOICE*	-	ALARM	RELAY OR COMPUTE*	-
Z	POSITION	-	-	DRIVE, ACTUATE OR UNCLASSIFIED FINAL CONTROL ELEMENT	-

* = SEE ISA "INSTRUMENTATION SYMBOLS AND IDENTIFICATION" MANUAL (AMERICAN NATIONAL STANDARD) 1981 EDITION, TABLE 1, PAGE 12.

- DPAH = DIFFERENTIAL PRESSURE ALARM (HIGH)
- DPSL = DIFFERENTIAL PRESSURE SWITCH (LOW)
- FE = FLOW ELEMENT
- FSL = FLOW SWITCH (LOW)
- FP = FLOW MEASURE
- FIR = FLOW INDICATOR AND RECORDER
- FI = FLOW INDICATOR
- FOI = FLOW REGULATOR
- LLA = LOW LEVEL ALARM
- LC = LEVEL CONTROL
- LSH = LEVEL SWITCH HIGH
- LSL = LEVEL SWITCH LOW
- LSHH = LEVEL SWITCH HIGH HIGH
- PDSL = DIFFERENTIAL PRESSURE SWITCH
- PI = PRESSURE INDICATOR (GAUGE)
- PSL = PRESSURE SWITCH (LOW)
- PSH = PRESSURE SWITCH (HIGH)
- S = SAMPLE
- TC = TEMPERATURE CONTROLLER
- TE = TEMPERATURE ELEMENT
- TI = TEMPERATURE INDICATOR (GAUGE)
- TIR = TEMPERATURE INDICATOR AND RECORDER
- TSL = TEMPERATURE SWITCH LOW
- TSH = TEMPERATURE SWITCH HIGH
- XIR = PH RECORDER
- XSL = PH (LOW)
- XSH = PH (HIGH)

SECTION & DETAIL IDENTIFICATION

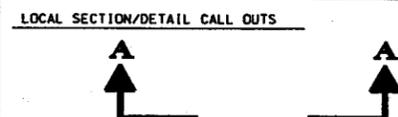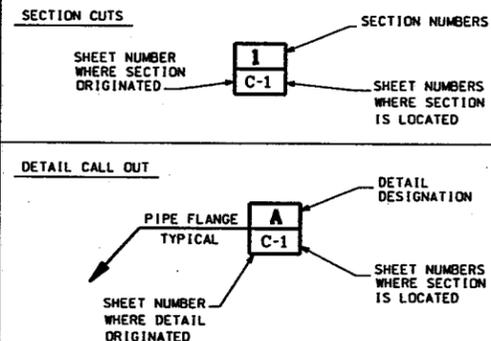

RECORD DRAWING

LEGEND & SYMBOLS

Scale: NONE Date: 7/95 Dwg. No.: G-3

FILE No. C:\PROJ\NEWMARK\NORTH\SYMHT.DGN



5/01	RECORD DRAWING		
NO.	DATE	DESCRIPTION	

DESIGNED BY:
DRAWN BY:
CHECKED BY:

URS URS Consultants, Inc.
CONSULTING ENGINEERS
SACRAMENTO CALIFORNIA


NEWMARK OU REMEDIAL DESIGN
NEWMARK GROUNDWATER
CONTAMINATION SUPERFUND SITE
17 TH STREET PLANT

JOB No. 62370.60

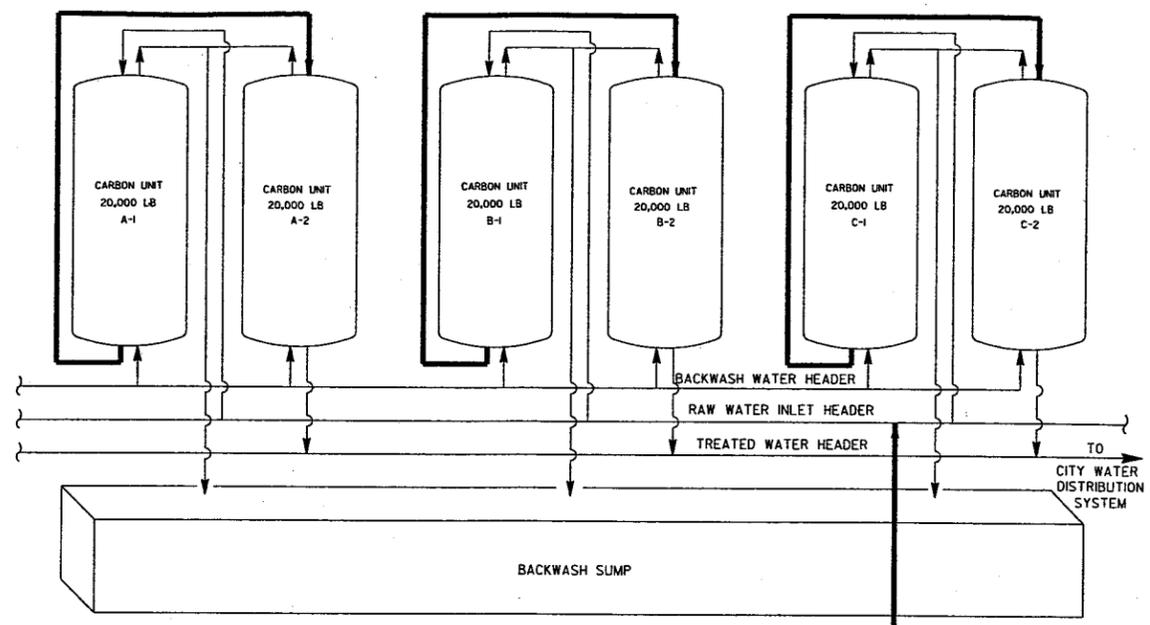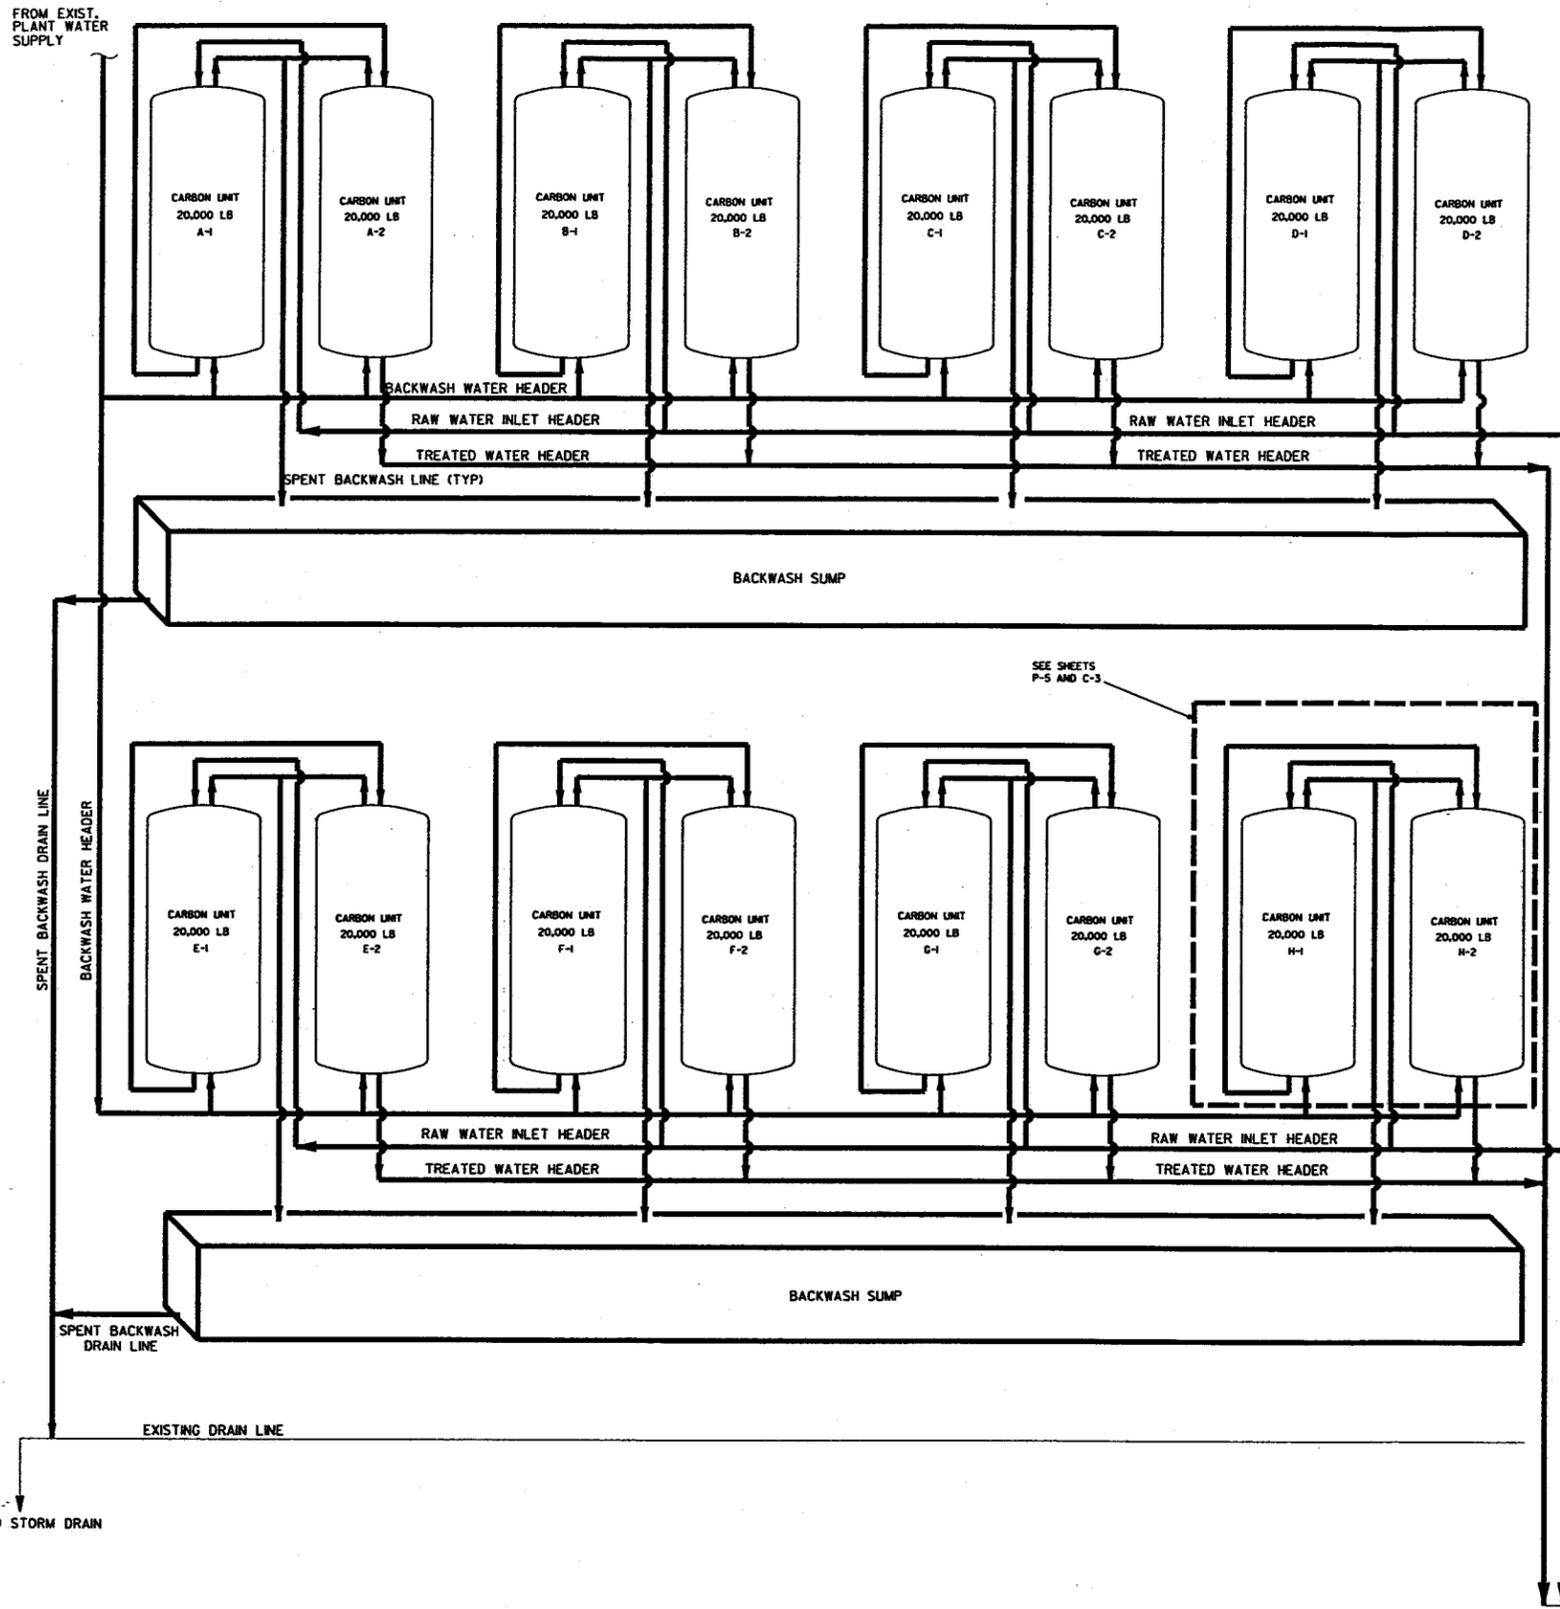

17 th STREET PLANT

NOTE:
MODIFICATION PIPING FOR DOUBLE-PASS OPERATION
TO BE INSTALLED BY THE CITY OF SAN BERNARDINO

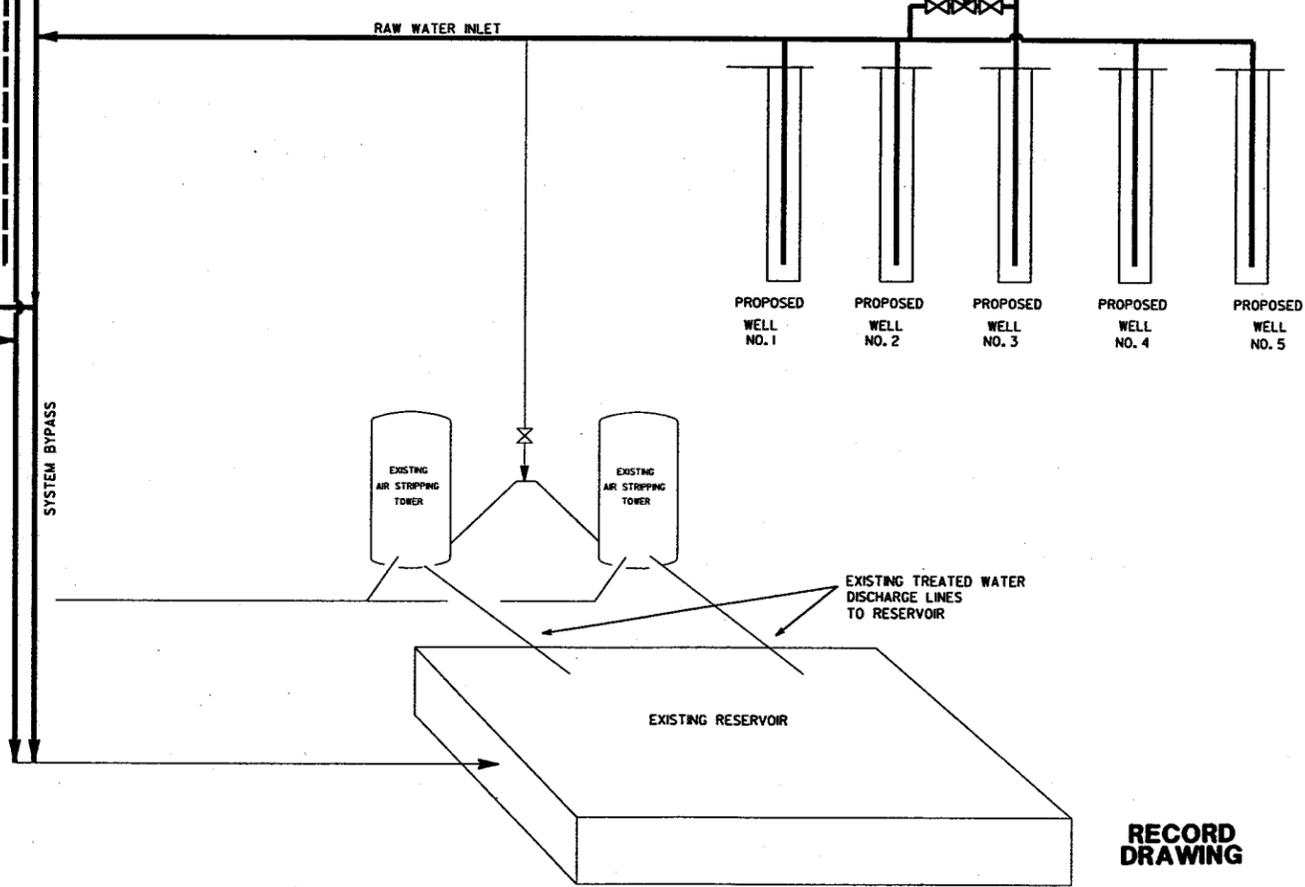

RECORD DRAWING

LEGEND :
— EXISTING
— NEW

NOTE:
CARBON UNITS WITH ALL RELATED PIPING, VALVING AND INSTRUMENTATION PROVIDED BY CARBON VENDOR

JOB No. 62370 FILE No. C:\PROJ\NEWMARK\WATER\PROCESS.DGN

5/01	RECORD DRAWING		
NO.	DATE	DESCRIPTION	NO. DATE DESCRIPTION
REVISIONS			

DESIGNED BY: GP
DRAWN BY: NDH
CHECKED BY: DHD

URS URS Consultants, Inc.
CONSULTING ENGINEERS
SACRAMENTO CALIFORNIA


JOB No. 62370



NEWMARK OU REMEDIAL DESIGN
NEWMARK GROUNDWATER
CONTAMINATION SUPERFUND SITE
NORTH & SOUTH PLANTS

SOUTH PLANTS PROCESS FLOW DIAGRAM		
Scale: NONE	Date: 2/98	Dwg. No.: P-6

FILE NO. C:\PROJ\NEWMARK\757\PNID.DGN
JOB No. 520

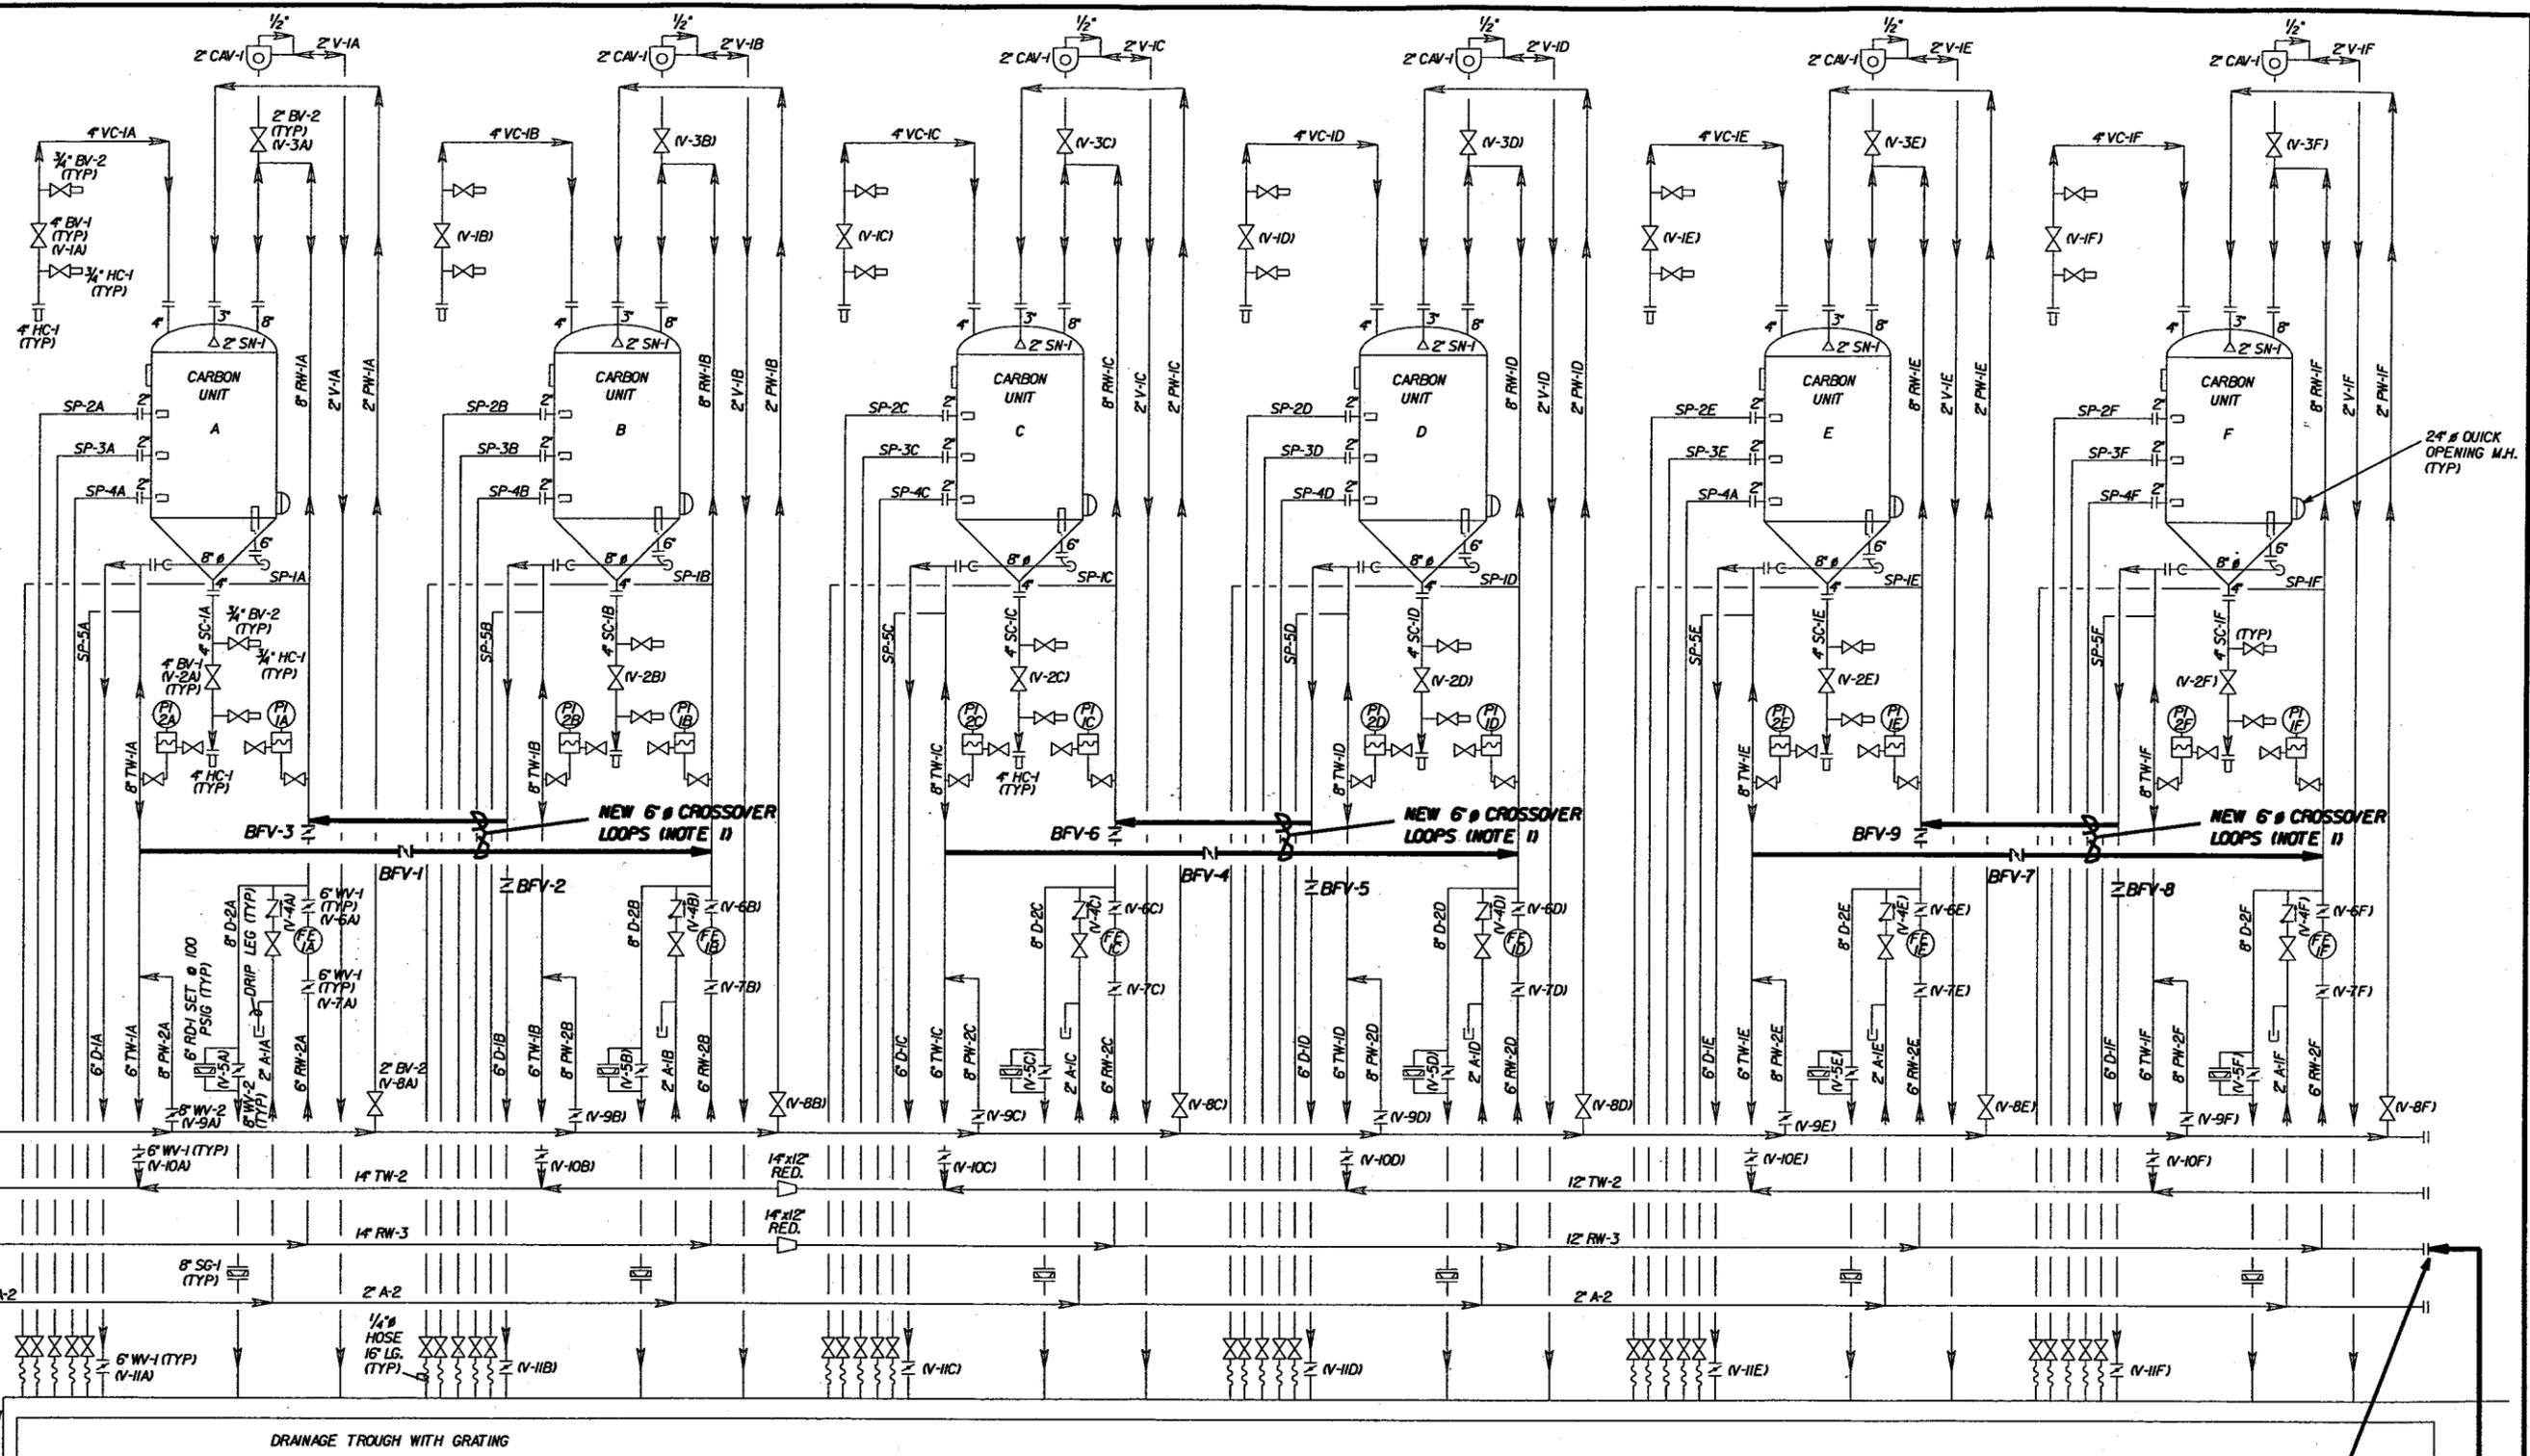

CARBON UNITS VALVE SCHEDULE					
LOCATION A & B		LOCATION C & D		LOCATION E & F	
VALVE NO.	SERVICE	VALVE NO.	SERVICE	VALVE NO.	SERVICE
BFV-1	CROSSOVER A TO B	BFV-4	CROSSOVER C TO D	BFV-7	CROSSOVER E TO F
BFV-2	DRAIN SHUTOFF	BFV-5	DRAIN SHUTOFF	BFV-8	DRAIN SHUTOFF
BFV-3	RAW WATER SHUTOFF	BFV-6	RAW WATER SHUTOFF	BFV-9	RAW WATER SHUTOFF

* CARBON UNIT PARALLEL MODE DESIGN FLOW AT 3100 GPM
* CARBON UNIT SERIAL MODE DESIGN FLOW AT 2000 GPM

NOTE 1:
CROSSOVER LOOP PIPING MATERIAL AND VALVE TYPE SHALL MATCH EXISTING (SEE SPECS). CROSSOVER LOOPS SHALL ALLOW SERIAL FLOW THROUGH TWO LPGAC VESSELS IN BOTH DIRECTIONS, I.E. FROM A TO B AND FROM B TO A. THIS ARRANGEMENT SHALL BE TYPICAL FOR CARBON UNITS A THROUGH F.

NEW PIPELINE CONNECTION

RECORD DRAWING

NO.	DATE	DESCRIPTION	NO.	DATE	DESCRIPTION
5/01		RECORD DRAWING			

DESIGNED BY: GP
DRAWN BY: NDH
CHECKED BY: DHD

URS URS Consultants, Inc.
CONSULTING ENGINEERS
SACRAMENTO CALIFORNIA
JOB No. 62370




NEWMARK OU REMEDIAL DESIGN
NEWMARK GROUNDWATER
CONTAMINATION SUPERFUND SITE
NORTH & SOUTH PLANTS

17th STREET
PIPING AND INSTRUMENTATION
DIAGRAM (P&ID)
Scale: NONE Date: 2/97 Dwg. No.: P-12

UNIT A
(C & E typ)

UNIT B
(D & F typ)

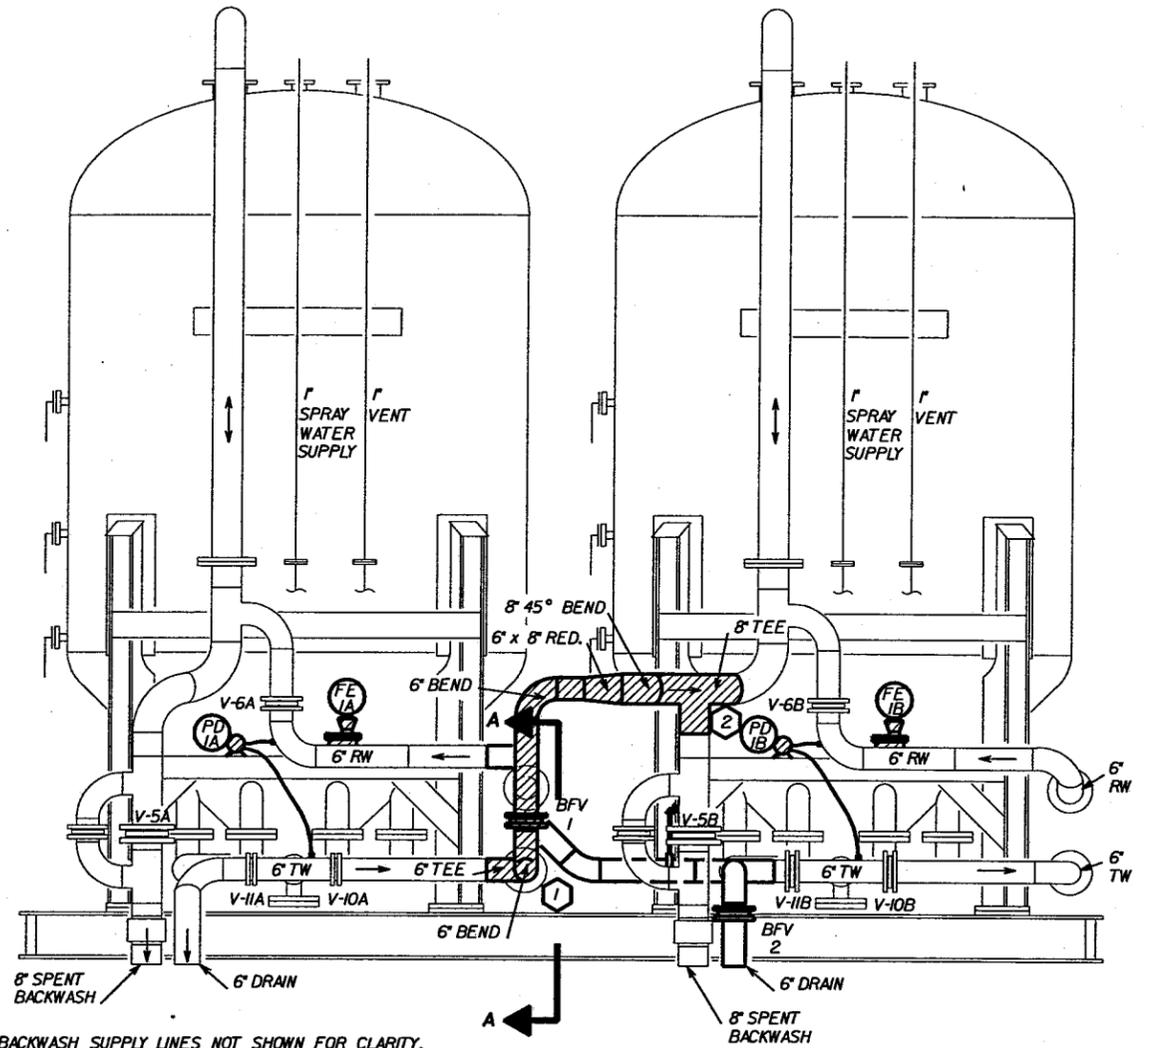


NOTES: 1. BACKWASH SUPPLY LINES NOT SHOWN FOR CLARITY. FOR CONTINUATION SEE SHEET P-12.
2. SEE ELECTRICAL DRAWINGS FOR ELECTRICAL INFORMATION.

SERIAL CONNECTION OF CARBON UNIT A WITH CARBON UNIT B 1


UNIT A
(C & E typ)

UNIT B
(D & F typ)

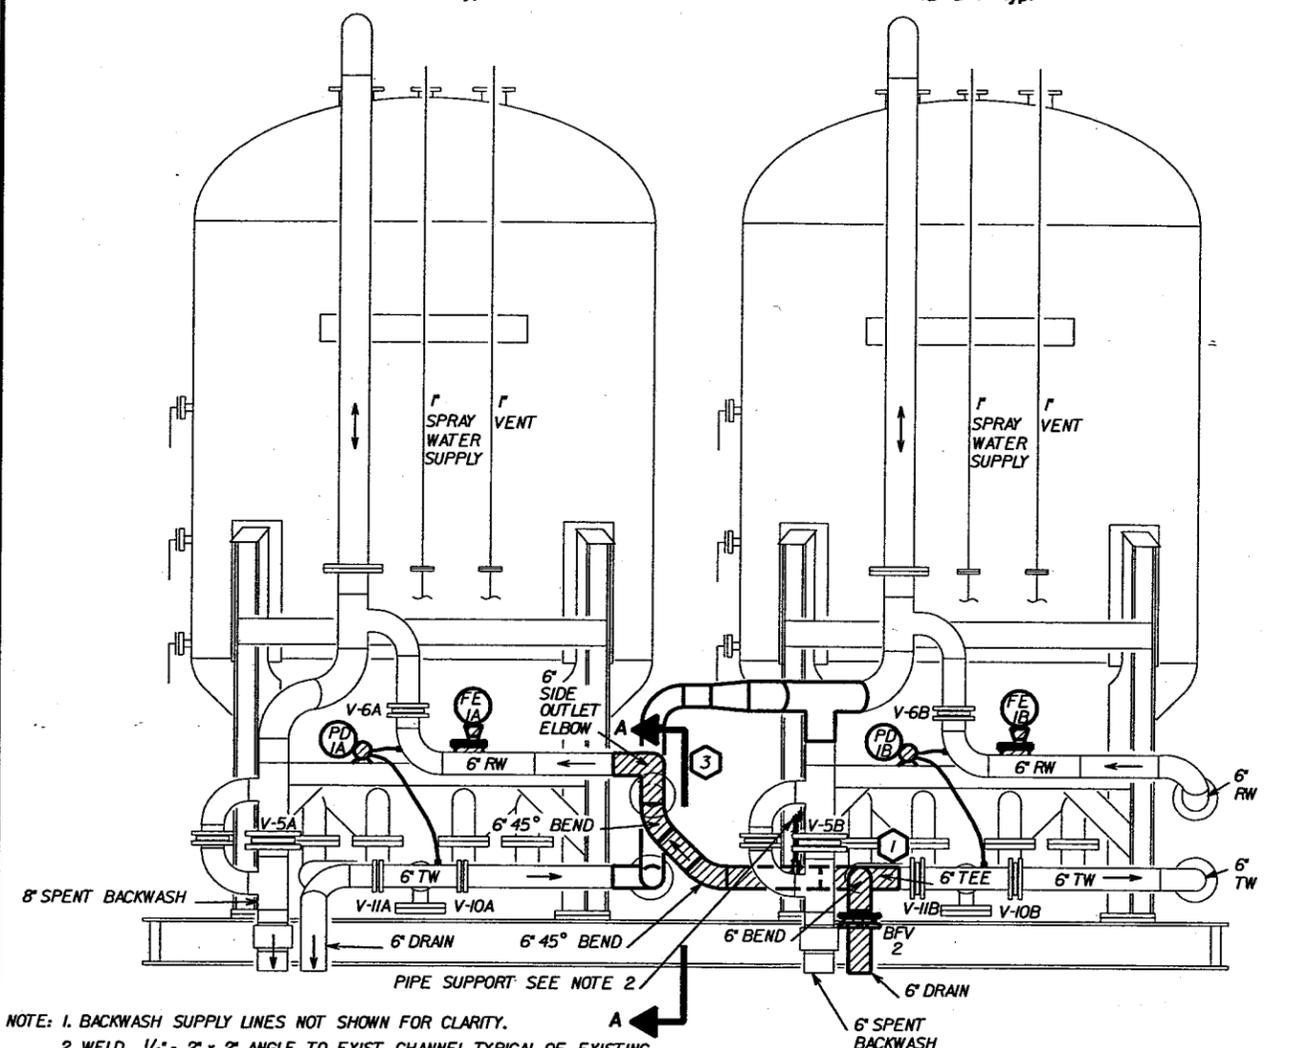

NOTE: 1. BACKWASH SUPPLY LINES NOT SHOWN FOR CLARITY.
2. WELD 1/4" - 2" x 2" ANGLE TO EXIST. CHANNEL, TYPICAL OF EXISTING. FOR SUPPORT OF 6" SERIAL CONNECTION OF CARBON UNIT B WITH CARBON UNIT A USE 'GRINNEL FIG 69' OR EQUAL PAINT TO MATCH EXISTING.

SERIAL CONNECTION OF CARBON UNIT B WITH CARBON UNIT A 2

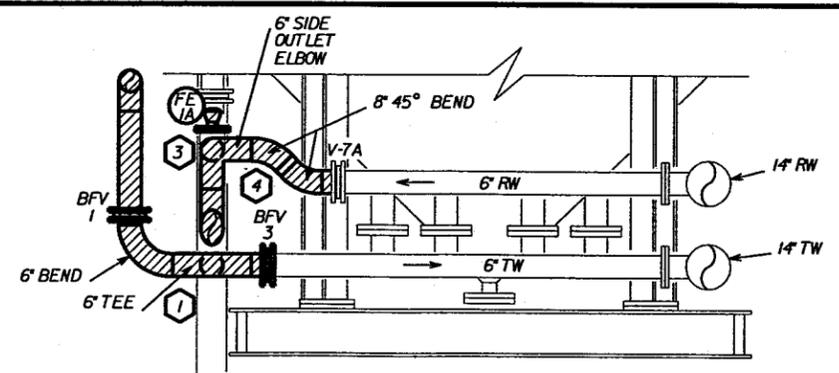

NOTE: BACKWASH SUPPLY LINES NOT SHOWN FOR CLARITY.

SECTION A-A

REQUIRED MODIFICATIONS AND CONNECTIONS TO EXISTING PIPING

- ① REMOVE EXISTING 6" BEND, REPLACE WITH 6" TEE
 - ② REMOVE EXISTING 8" BEND, REPLACE WITH 8" TEE
 - ③ REMOVE EXISTING 6" BEND, REPLACE WITH 6" SIDE OUTLET BEND
 - ④ INSTALL TWO NEW 45° BENDS, RELOCATE V-7A ACCORDINGLY.
- ▨ NEW PIPING AND FITTINGS

NOTE: 1. NEW CONNECTIONS AND PIPING TO BE WELDED STEEL.
2. ALL NEW VALVES TO BE FLANGED CONNECTIONS.

RECORD DRAWING

JOB No. 5201 FILE No. C:\PROJ\NEWMARK\75\17PIPE.DGN

1	5/01	RECORD DRAWING		
NO.	DATE	DESCRIPTION	NO.	DATE
REVISIONS				

DESIGNED BY: GP
DRAWN BY: NDH
CHECKED BY: DHD

URS URS Consultants, Inc.
CONSULTING ENGINEERS
SACRAMENTO CALIFORNIA


JOB No. 62370



NEWMARK OU REMEDIAL DESIGN
NEWMARK GROUNDWATER
CONTAMINATION SUPERFUND SITE
NORTH & SOUTH PLANTS

17th STREET
TYPICAL CARBON UNIT
CROSSOVER LOOP PIPING


Scale: 1/2" = 1'-0" Date: 2/97 Dwg. No.: C-14

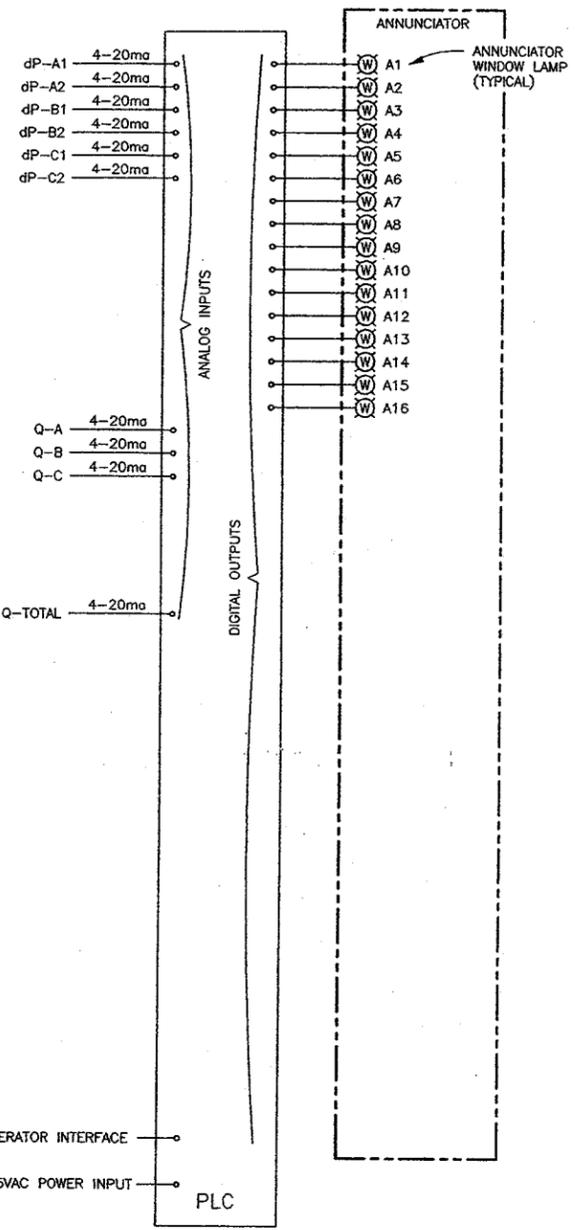

PLC BLOCK DIAGRAM

dP-() = DIFFERENTIAL PRESSURE SIGNAL
 Q-() = FLOW SIGNAL
 A() = ANNUNCIATOR LAMP OUTPUT

SHOWN FOR SITE WITH EIGHT PAIR OF FILTERS AND SIMILAR FOR ALL EXCEPT MODIFIED FOR THE NUMBER OF FILTER PAIRS.

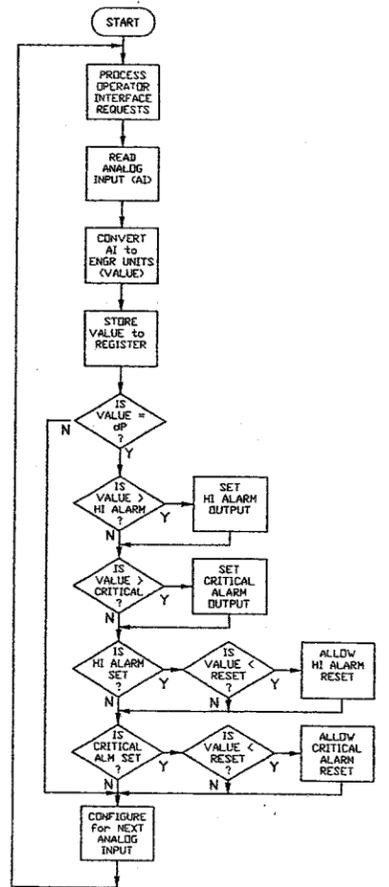

PLC PROGRAM REQUIREMENTS:

- P1. THE PROGRAM SHALL INCLUDE AN AVERAGING ALGORITHM FOR THE ANALOG INPUTS. THE PARAMETERS FOR THE AVERAGING ALGORITHM SHALL BE ADJUSTABLE (THROUGH PROGRAM MODIFICATIONS - NOT THROUGH OIT). AS AN ALTERNATIVE, THE AVERAGING CAN BE CONFIGURED WITH THE HARDWARE AS A PART OF THE ANALOG INPUT CARDS.
- P2. THE PROGRAM SHALL TEST ANALOG INPUT REASONABILITY (I.E. $4ma < AI < 20ma$). ANALOG INPUTS WHICH FAIL REASONABILITY SHALL BE ALARMED WITH MESSAGE TO THE OIT.


OPERATOR INTERFACE REQUIREMENTS:

- O1. SELECTIVELY VIEW DIFFERENTIAL PRESSURE VALUES
- O2. SELECTIVELY VIEW FILTER FLOW VALUE
- O3. CHANGE DIFFERENTIAL PRESSURE HIGH ALARM SETPOINT
- O4. CHANGE DIFFERENTIAL PRESSURE CRITICAL ALARM SETPOINT
- O5. CHANGE DIFFERENTIAL PRESSURE HIGH ALARM RESET POINT
- O6. CHANGE DIFFERENTIAL PRESSURE CRITICAL ALARM RESET POINT
- O7. INITIATE ALARM AKNOWLEDGE
- O8. INITIATE ALARM RESET
- O9. INITIATE ANNUNCIATOR LAMP TEST

ANNUNCIATOR FUNCTION and SEQUENCE

- A1. WHEN ALARM CONDITION EXISTS, APPROPRIATE ANNUNCIATOR WINDOW SHALL FLASH AT THE RATE 1/2 SEC ON, 1/2 SEC OFF.
- A2. WHEN ALARM IS ACKNOWLEDGED (OIT FUNCTION KEY), FLASHING DISPLAY SHALL BE REPLACED WITH STEADY ON DISPLAY. IF ADDITIONAL ALARMS OCCUR AFTER ACKNOWLEDGE FUNCTION HAS BEEN INITIATED, THESE SHALL FLASH UNTIL SUBSEQUENTLY ACKNOWLEDGED.
- A3. WHEN ALARM IS RESET (OIT FUNCTION KEY), ALL INDICATIONS NOT CURRENTLY IN ALARM CONDITION SHALL BE EXTINGUISHED. INDICATIONS REMAINING IN ALARM CONDITION SHALL CONTINUE TO ILLUMINATE.
- A4. WHEN LAMP TEST (OIT FUNCTION KEY) IS INITIATED, ALL LAMPS SHALL ILLUMINATE FOR A THREE SECOND PERIOD.

PLC LOGIC DIAGRAM

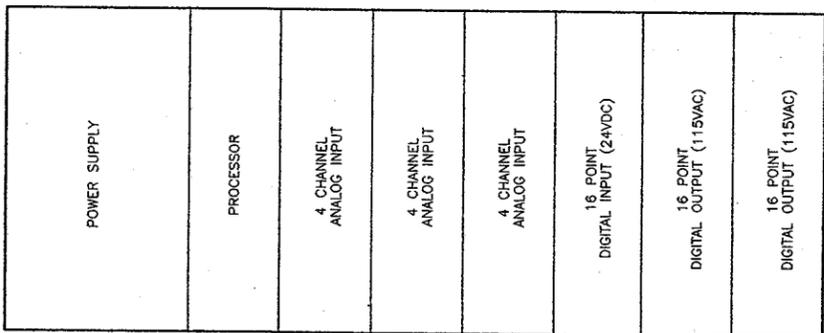

PLC CHASSIS LAYOUT

FILTER GROUP No.	A
FLT #1 dP:	XX.X In.
FLT #2 dP:	XX.X In.
FLOW:	XXX.X GPM

OPERATOR INTERFACE TERMINAL TYPICAL DISPLAY MESSAGE

SHOWN for FILTER GROUP No. A AND TYPICAL for GROUPS B THROUGH H

NO.	DATE	DESCRIPTION	NO.	DATE	DESCRIPTION
1	5/22/98	REVISED FOR 17TH STREET STATION			

DESIGNED BY: WRP
 DRAWN BY: CAD
 CHECKED BY: RLH

URS URS Consultants, Inc.
 CONSULTING ENGINEERS
 SACRAMENTO CALIFORNIA




NEWMARK OU REMEDIAL DESIGN
 NEWMARK GROUNDWATER
 CONTAMINATION SUPERFUND SITE
 17TH STREET STATION



CARBON FILTER PANEL
 PLC DIAGRAMS

SCALE: NONE Date: APRIL, 1997 Dwg. No.: E-2



JOB No. 62370.60.30

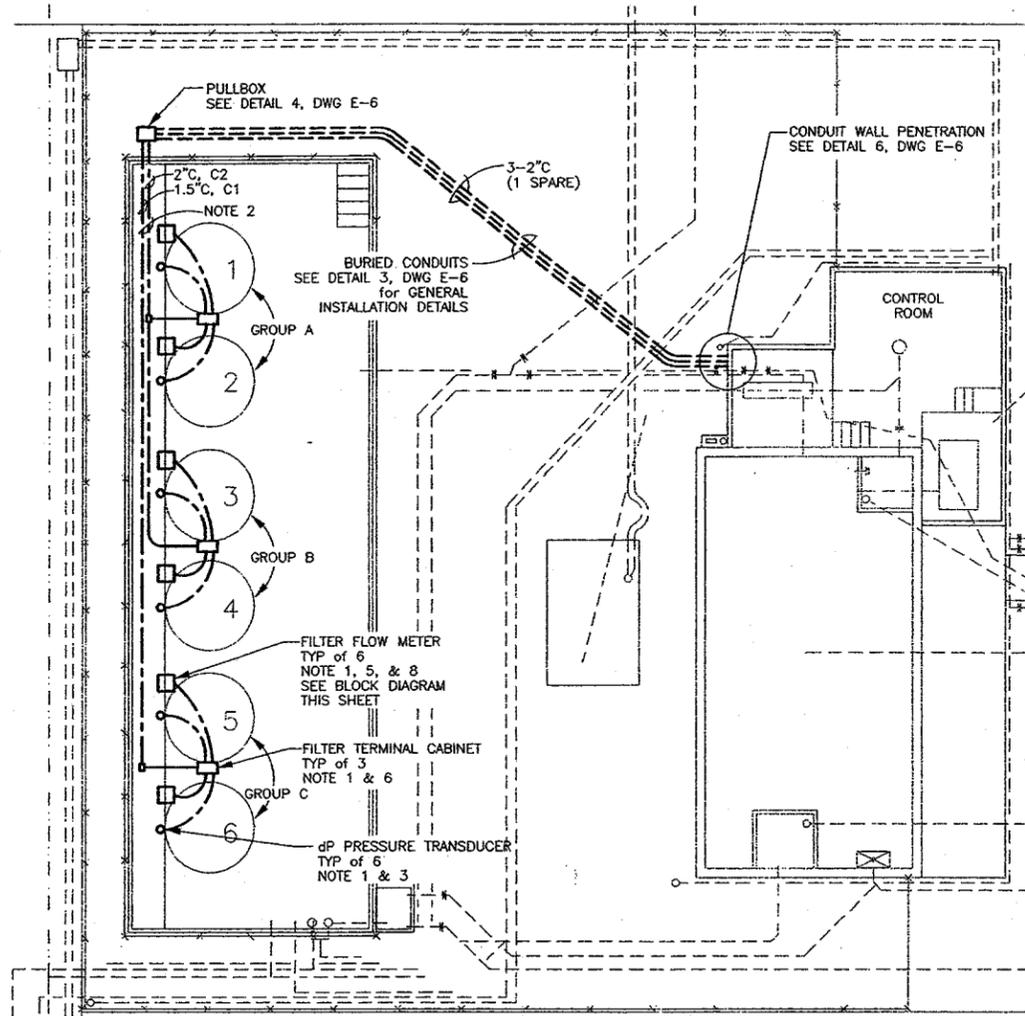

17th STREET SITE PLAN

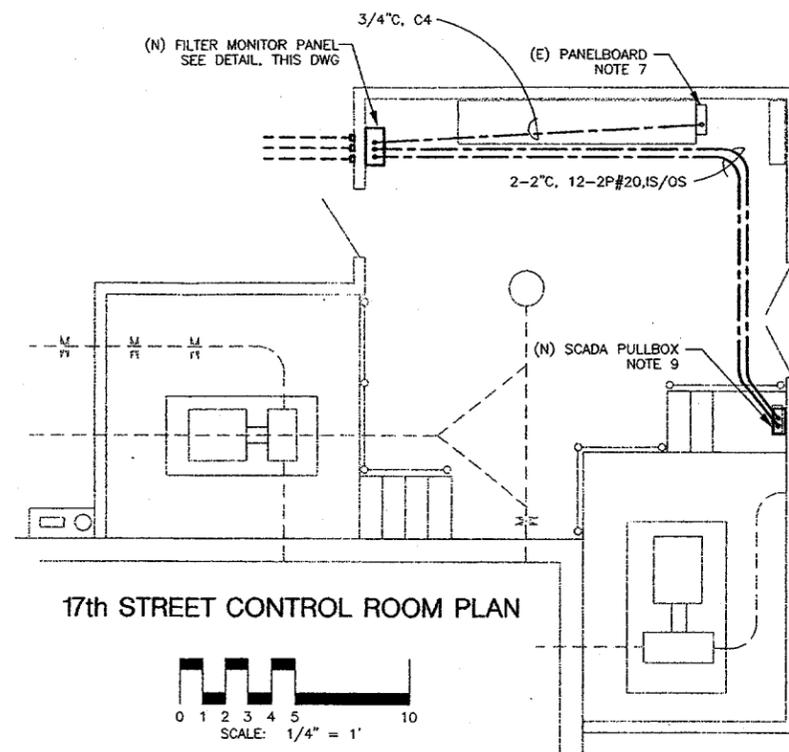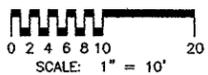


17th STREET CONTROL ROOM PLAN

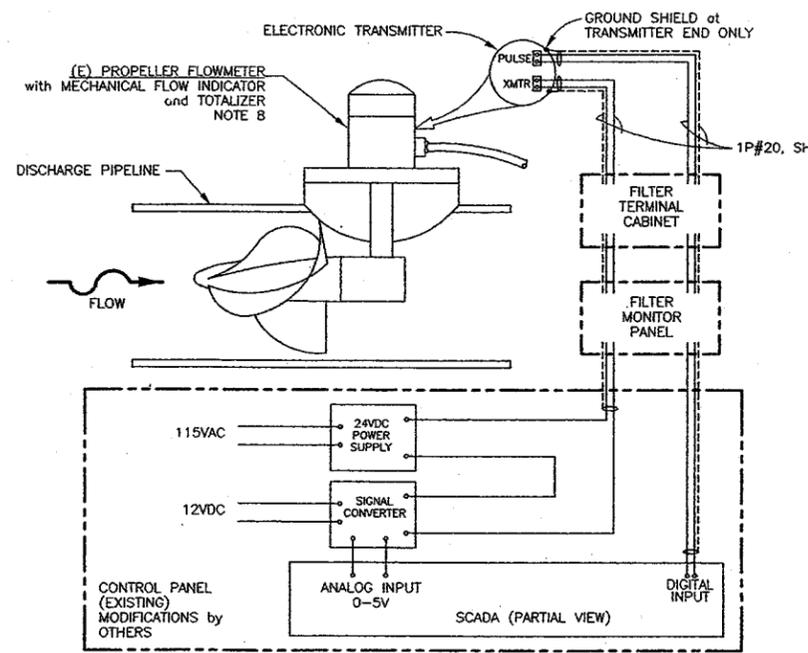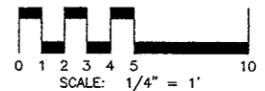

FLOW METER BLOCK DIAGRAM

NOTES:

- LOCATION OF DEVICES ON CARBON FILTER SHOWN FOR PURPOSE OF ILLUSTRATION ONLY. CONTRACTOR SHALL ADJUST ROUTING OF INTERCONNECTING CONDUIT TO SUIT FIELD CONDITIONS. CONDUIT TO FIELD DEVICES SHALL BE RGS AND LIQUID-TITE FLEXIBLE METAL.
- EXTEND CONDUITS FROM GRADE UP TO LEVEL OF FILTER TANK UPPER PIPE SUPPORT. CONDUIT RISERS CAN BE SUPPORTED ON EXISTING HANDRAIL. CONDUITS SHALL BE SURFACE ROUTED AND EXTEND AS NECESSARY ALONG LENGTH OF FILTER TANK ASSEMBLIES SUPPORTED TO UPPER PIPE SUPPORTS.
- FIELD ROUTE 1P#20 SH CABLE IN 1/2" CONDUIT FROM dP PRESSURE TRANSDUCER TO FILTER TERMINAL CABINET.
- NOT USED.
- FIELD ROUTE 2P#20, IS/OS CABLE IN 3/4" CONDUIT FROM FILTER FLOW METER TO FILTER TERMINAL CABINET.
- FILTER TERMINAL CABINET SHALL BE PROVIDED BY THE CONTRACTOR TO INTERFACE FIELD DEVICE WIRING WITH CARBON MONITOR PANEL. THE FILTER TERMINAL CABINET SHALL BE NEMA 4, 24"H X 20"W X 6"D WITH HINGED AND CLAMPED DOOR, BACK PANEL, AND INTERFACE TERMINAL BOARDS. THE CABINET SHALL BE MOUNTED TO THE FILTER ASSEMBLY AT A CONVENIENT LOCATION. INTERFACE TERMINALS SHALL BE PROVIDED FOR:
 - FILTER 1 dP TRANSDUCER
 - FILTER 2 dP TRANSDUCER
 - FILTER FLOW METER SIGNAL
 - FILTER FLOW PULSE OUTPUT
 GROUND TERMINALS SHALL BE PROVIDED FOR ALL CABLE SHIELDS. A MINIMUM OF 20% SPARE TERMINAL POINTS SHALL BE PROVIDED. INTERFACE CABLES TO THE FILTER MONITOR PANEL SHALL BE 4-2P#20, IS/OS (1 SPARE). FILTER DEVICES SHALL BE AS NOTED (NOTES 2 - 5).
- MODIFY EXISTING PANELBOARD BY REPLACING ONE ITE TYPE "QP", 1-POLE, 20A BREAKER WITH ONE ITE TYPE "QT", 2-POLE, 20A BREAKER THAT PLUGS INTO THE SAME SPACE AS THE REPLACED BREAKER. RECONNECT THE EXISTING CIRCUIT TO ONE OF THE NEW BREAKER POLES AND FEED THE NEW FILTER CONTROL PANEL WITH THE OTHER NEW BREAKER POLE.
- MODIFY THE EXISTING WATER SPECIALTIES, INC. WATER FLOW METERS TO ADD ELECTRONIC FLOW TRANSMITTER WITH ANALOG OUTPUT AND DIGITAL PULSE.
- PROVIDE NEW JUNCTION/PULLBOX, 12" X 18" X 6", NEMA 1, INSTALLED NEAR CEILING ABOVE EXISTING SCADA CABINET, AND TERMINATE CONDUITS ROUTED FROM FILTER MONITOR PANEL. CABLE ENDS SHALL BE CLEARLY MARKED AND IDENTIFIED AND COILED WITHIN BOX WITH 10' EXTENDED CABLE LENGTH. ALL ANALOG SIGNAL CABLE PAIRS SHALL BE JUMPED AT THE FILTER MONITOR PANEL TERMINAL BOARDS.
- SUBSURFACE CONDUITS SHALL BE PVC, SCHEDULE 40. SURFACE ROUTED CONDUITS SHALL BE RGS. TRANSITION CONDUITS FROM SURFACE TO SUBSURFACE SHALL BE PVC COATED RGS OR PVC WRAPPED RGS.
- THIS DRAWING ILLUSTRATES SITE PLAN FOR 17TH STREET STATION. REFER TO DRAWING E-1 FOR BLOCK DIAGRAM OF FILTERS AND LAYOUT OF FILTER MONITOR PANEL. REFER TO DRAWING E-2 FOR PLC DIAGRAM AND MODIFY TO SUIT THIS APPLICATION. REFER TO DRAWINGS E-6 AND E-7 FOR APPLICABLE DETAILS.

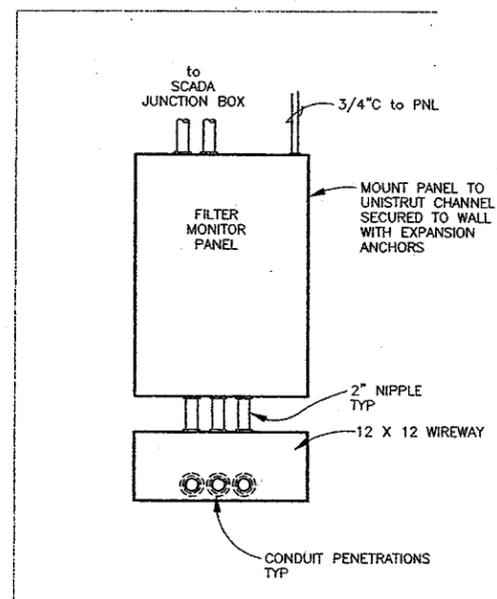

FILTER MONITOR PANEL

NO SCALE

DESIGNATIONS:

- C1 4-2P#20, IS/OS
- C2 8-2P#20, IS/OS
- C3 NOT USED
- C4 2#12 & #12G, THWN
- C5 NOT USED
- 2P#20 = TWO PAIR, #20AWG, STRANDED, COPPER, 300V
- IS/OS = INDIVIDUALLY SHIELDED WITH OVERALL SHIELD
- SURFACE ROUTED CONDUIT
- SUBSURFACE ROUTED CONDUIT
- (E) EXISTING
- (N) NEW

DESIGNED BY: WRP
 DRAWN BY: CAD
 CHECKED BY: RLH

URS URS Consultants, Inc.
 CONSULTING ENGINEERS
 SACRAMENTO CALIFORNIA



NEWMARK OU REMEDIAL DESIGN
 NEWMARK GROUNDWATER
 CONTAMINATION SUPERFUND SITE
 17TH STREET STATION

CARBON FILTER / 17th STREET
 ELECTRICAL SITE PLAN


SCALE: AS SHOWN Date: APRIL, 1997 Dwg. No.: E-5

NS-E5 / 1-1


NO.	DATE	DESCRIPTION	NO.	DATE	DESCRIPTION
REVISIONS					

JOB No62370.60.30


NOT USED

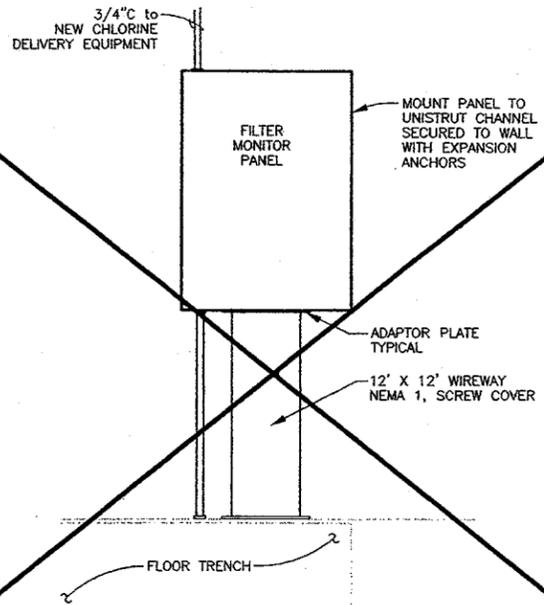


FILTER MONITOR PANEL - SOUTH PLANT
NO SCALE

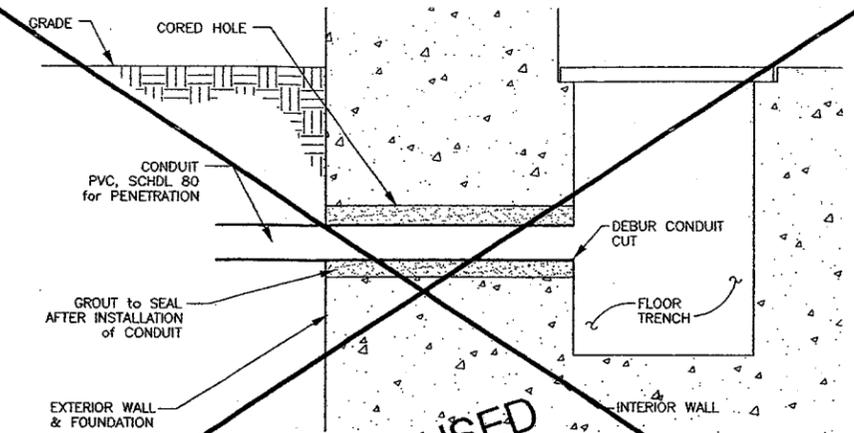


DETAIL 1
BLOCK/CONCRETE WALL CONDUIT PENETRATION - WATERMAN
FOR EXTERIOR to INTERIOR PENETRATIONS

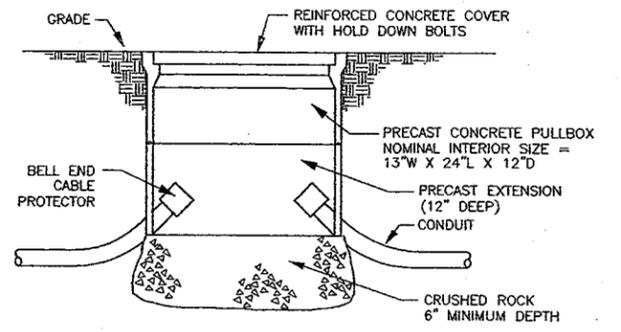


DETAIL 4 - PRECAST PULLBOX

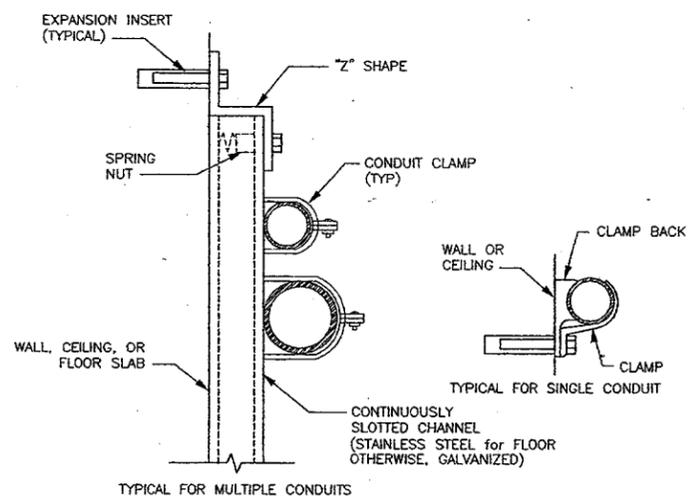

DETAIL 2 - CONDUIT SUPPORTS

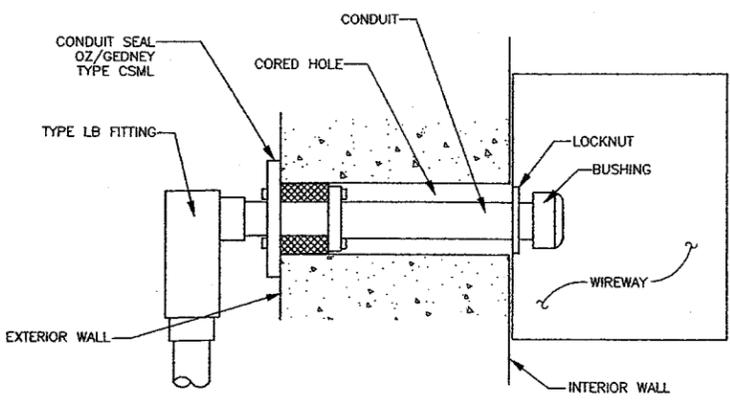


DETAIL 6
BLOCK/CONCRETE WALL CONDUIT PENETRATION
FOR EXTERIOR to INTERIOR PENETRATIONS

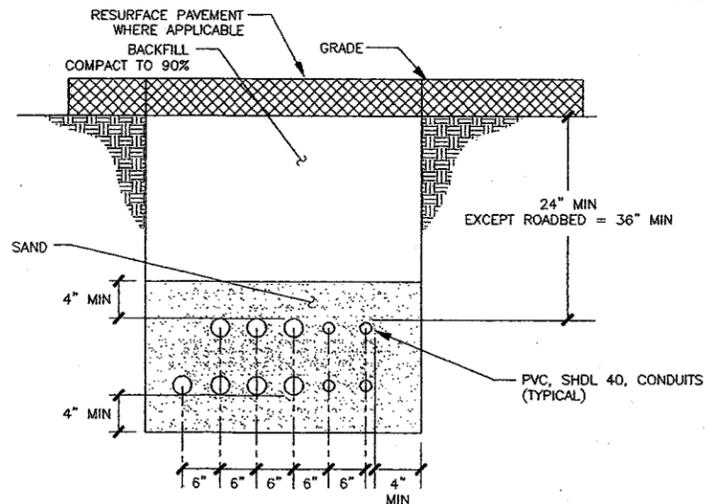

DETAIL 3 - DUCTBANK

NOT USED

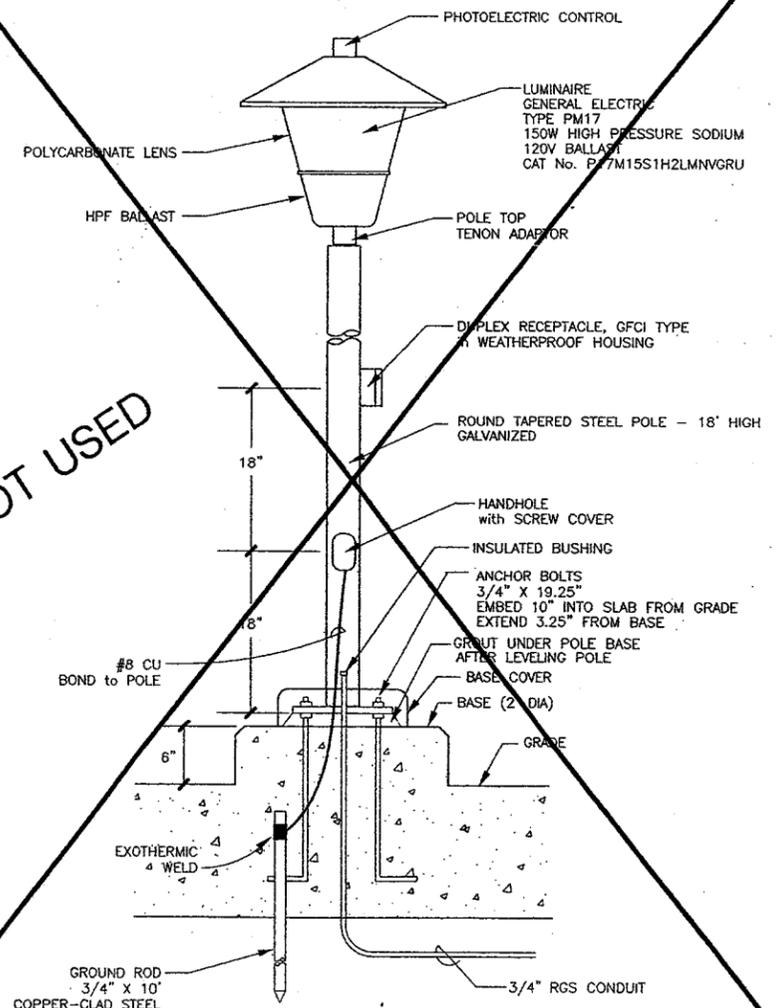


DETAIL 5 - AREA LIGHT POLE

NO.	DATE	DESCRIPTION	NO.	DATE	DESCRIPTION
1	5/22/98	REVISED FOR 17TH STREET STATION			

DESIGNED BY: WRP
 DRAWN BY: CAD
 CHECKED BY: RLH

URS URS Consultants, Inc.
 CONSULTING ENGINEERS
 SACRAMENTO CALIFORNIA

JOB No. 62370.60.30

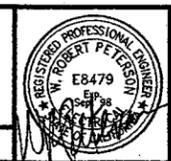

NEWMARK OU REMEDIAL DESIGN
 NEWMARK GROUNDWATER
 CONTAMINATION SUPERFUND SITE
 17TH STREET STATION

ELECTRICAL DETAILS	
SCALE: AS SHOWN	Date: APRIL, 1997
Dwg. No.: E-6	

FILE: NS-E6: 1

UNITED STATES ENVIRONMENTAL PROTECTION AGENCY
REGION IX


RECORD DRAWING

NEWMARK OU REMEDIAL DESIGN
NEWMARK GROUNDWATER
CONTAMINATION SUPERFUND SITE
NORTH PLANT TRANSMISSION PIPELINE

PREPARED BY
URS CONSULTANTS, INC.
SAN BERNARDINO, CA.

SEPTEMBER 1997

RECORD
DRAWING

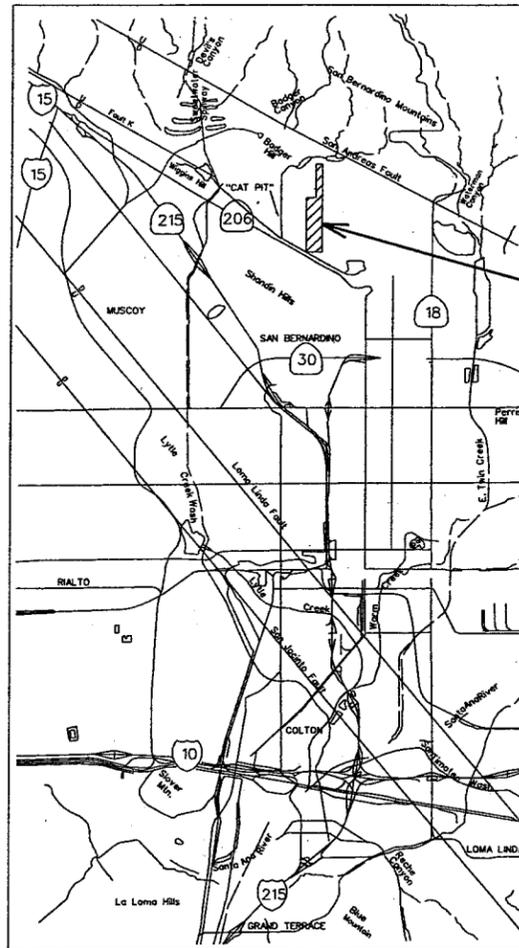


VICINITY MAP

PROJECT SITE

GENERAL NOTES

- BENCHMARK (ELEV. 1409.941 FEET) IS A BRASS DISK STAMPED "R CLARK WILSON, L.S. 3223" LOCATED 3 FEET EAST OF THE WEST END OF A CONCRETE HEADWALL OF A FLOOD CONTROL BRIDGE OVER THE DEVIL CREEK CHANNEL NORTH OF 42ND STREET ON LITTLE MOUNTAIN DRIVE. CITY OF SAN BERNARDINO DESIGNATION A6-13A, SET 1985.
- CONTRACTOR ASSUMES FULL RESPONSIBILITY FOR PROTECTION OF EXISTING FACILITIES FROM DAMAGE DUE TO CONTRACTOR'S OPERATIONS.
- CONTRACTOR AGREES TO ENSURE THAT ALL WORK IS PERFORMED IN A MANNER WHICH MINIMIZES DISTURBANCE TO OWNER'S ONGOING ACTIVITIES AT THE SITE. CONTRACTOR SHALL ENFORCE STRICT DISCIPLINE AND GOOD ORDER AMONG ITS EMPLOYEES AT ALL TIMES. CONTRACTOR SHALL NOT EMPLOY ANY PERSON UNFIT OR UNSKILLED IN ANY PROJECT ASSIGNED TO HIM.
- OSHA PERMIT IS REQUIRED FOR TRENCHES OVER 5 FT. IN DEPTH, PRIOR TO START OF TRENCH EXCAVATION.
- ALL WATERLINE CONNECTION POINTS AND CRITICAL UTILITY CROSSINGS POINTS SHALL BE EXPOSED AND ACCURATELY LOCATED AT THE START OF CONSTRUCTION, AND THE SBMWD SHALL BE NOTIFIED OF ANY DISCREPANCIES PRIOR TO THE CONTINUATION OF WORK.
- THE CONTRACTOR SHALL NOT OPEN MORE TRENCHES THAN CAN BE PROPERLY PROSECUTED IN A DAY'S OPERATION. ANY TRENCH UNAVOIDABLY LEFT OPEN DURING THE HOURS OF DARKNESS OR OVER A WEEKEND SHALL BE FENCED WITH A 6-FOOT CHAIN LINK FENCING AND PROPERLY LIGHTED, OR BRIDGE BY A SBMWD APPROVED TRAFFIC PLATE WITH REFERENCE TO THE W.A.T.C.H. MANUAL.
- THE CONTRACTOR SHALL REINSTALL PAVEMENT MARKINGS AND STRIPPING THAT HAVE BEEN DISTURBED BY HIS OPERATIONS.
- THE CONTRACTOR SHALL PROVIDE SAFE AND CONTINUOUS PASSAGE FOR LOCAL PEDESTRIAN AND VEHICULAR TRAFFIC AT ALL TIMES WITH REFERENCE TO THE W.A.T.C.H. MANUAL.
- TRAFFIC SIGNALS FUNCTIONS SHALL BE THE RESPONSIBILITY OF THE CITY OF SAN BERNARDINO, DEPARTMENT OF PUBLIC WORKS; HOWEVER, THE CONTRACTOR IS REQUIRED TO GIVE 48-HOUR NOTICE PRIOR TO ANY CONSTRUCTION THAT MAY DAMAGE OR AFFECT BURIED TRAFFIC DETECTORS.
- THE CONTRACTOR SHALL SO CONDUCT HIS OPERATIONS AS TO OFFER THE LEAST POSSIBLE OBSTRUCTION AND INCONVENIENCE TO THE PUBLIC, AND HE SHALL HAVE UNDER CONSTRUCTION NO GREATER LENGTH OR AMOUNT OF WORK THAT HE CAN PROSECUTE PROPERLY WITH DUE REGARD TO THE RIGHTS OF THE PUBLIC. CONVENIENT ACCESS TO DRIVEWAYS, HOUSES, AND BUILDINGS ALONG THE LINE OF WORK SHALL BE MAINTAINED.

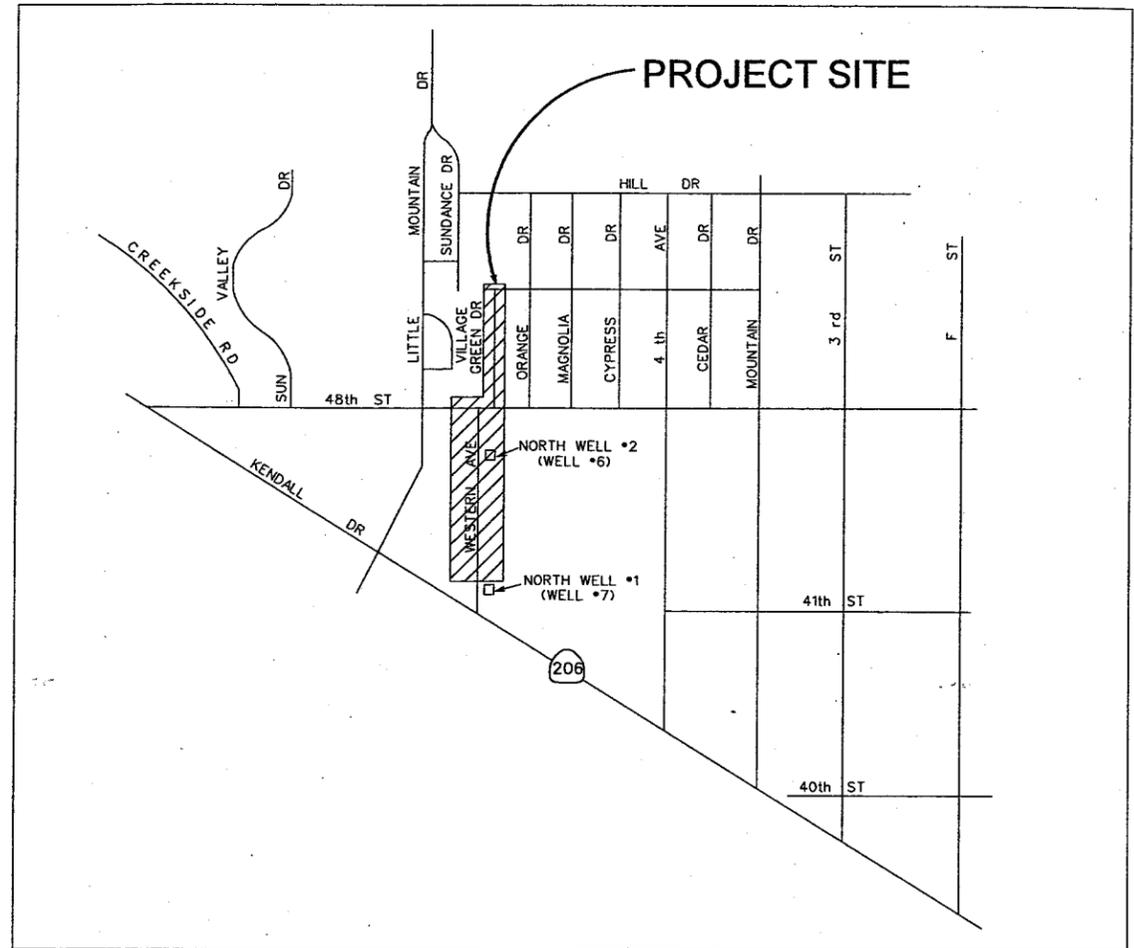

LOCATION MAP

PRIVATE ENGINEER'S NOTES TO CONTRACTOR

THE EXISTENCE AND LOCATION OF ANY UNDERGROUND UTILITY PIPES, CONDUITS OR STRUCTURES SHOWN ON THESE PLANS ARE OBTAINED BY A SEARCH OF THE AVAILABLE RECORDS. TO THE BEST OF OUR KNOWLEDGE THERE ARE NO UTILITIES EXCEPT AS SHOWN ON THESE PLANS. THE CONTRACTOR IS REQUIRED TO TAKE DUE PRECAUTIONARY MEASURES TO PROTECT THE UTILITY LINES SHOWN ON THESE DRAWINGS. THE CONTRACTOR FURTHER ASSUMES ALL LIABILITY AND RESPONSIBILITY FOR THE UTILITY PIPES, CONDUIT OR STRUCTURES SHOWN OR NOT SHOWN ON THESE DRAWINGS.

CONTRACTOR AGREES THAT HE SHALL ASSUME SOLE AND COMPLETE RESPONSIBILITY FOR JOB SITE CONDITIONS DURING THE COURSE OF CONSTRUCTION OF THIS PROJECT INCLUDING SAFETY OF ALL PERSONS AND PROPERTY; THAT THIS REQUIREMENT SHALL APPLY CONTINUOUSLY AND NOT BE LIMITED TO NORMAL WORKING HOURS; AND THAT THE CONTRACTOR SHALL DEFEND, INDEMNIFY AND HOLD THE OWNER AND THE ENGINEER HARMLESS FROM ANY AND ALL LIABILITY, REAL OR ALLEGED IN CONNECTION WITH THE PERFORMANCE OF WORK ON THIS PROJECT, EXCEPTING FOR LIABILITY ARISING FROM THE SOLE NEGLIGENCE OF THE OWNER OR THE ENGINEER.

DIG ALERT

DIAL TOLL FREE
1-800-422-4133

AT LEAST TWO DAYS
BEFORE YOU DIG

UNDERGROUND SERVICE ALERT OF SOUTHERN CALIFORNIA

RECORD
DRAWING

NO.	DATE	DESCRIPTION	NO.	DATE	DESCRIPTION
1	1/99	RECORD DRAWING			
REVISIONS					

DESIGNED BY: STL/MA
DRAWN BY: JW/NH
CHECKED BY: DHD

URS URS Consultants, Inc.
CONSULTING ENGINEERS
SACRAMENTO CALIFORNIA



JOB No. 62370


NEWMARK OU REMEDIAL DESIGN
NEWMARK GROUNDWATER
CONTAMINATION SUPERFUND SITE
SOUTH PLANT TRANSMISSION PIPELINE

LOCATION MAPS &
GENERAL NOTES

Scale: AS SHOWN Date: JULY 31, 1997 Dwg. No.: 1

IF SHEET IS LESS THAN
24"x36"
IT IS A REDUCED PRINT.
SCALE REDUCED ACCORDINGLY.

SANBERDO.62370-53.RECORD.DWG

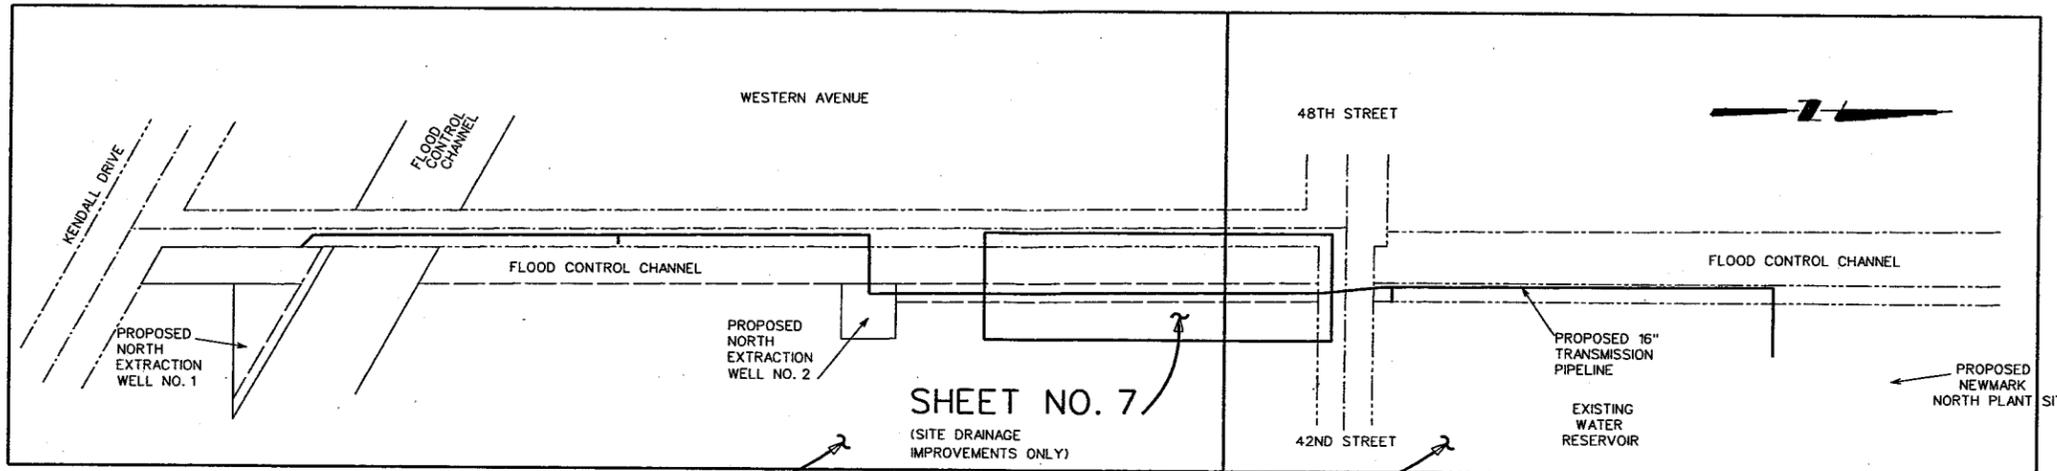

SHEET NO. 3

SHEET NO. 4

SHEET NO. 7
(SITE DRAINAGE IMPROVEMENTS ONLY)

LEGEND

- EXISTING BURIED FACILITY
- CENTERLINE
- RIGHT-OF-WAY
- NEW PIPELINE
- MANHOLE
- GATE VALVE
- REDUCER
- BUTTERFLY VALVE
- COMBINATION AIR VALVE
- BLOW OFF

ABBREVIATIONS

- | | | | |
|-----|--------------------------|--------|--|
| ARV | AIR RELEASE VALVE | MJ | MECHANICAL JOINT |
| BF | BLIND FLANGE | N.C. | NORMALLY CLOSED |
| BFV | BUTTERFLY VALVE | N.O. | NORMALLY OPEN |
| BO | BLOW OFF | PRV | PRESSURE REDUCING VALVE |
| CAV | COMBINATION AIR VALVE | RCP | REINFORCED CONCRETE PIPE |
| CL | CEMENT LINED | RED | REDUCER |
| CL | CENTERLINE | RW | RIGHT-OF-WAY |
| D | DRAIN | S | SLOPE |
| DIP | DUCTILE IRON PIPE | SBCFCD | SAN BERNARDINO COUNTY FLOOD CONTROL DISTRICT |
| E | ELECTRICAL | SS | SANITARY SEWER |
| ECC | ECCENTRIC | STA | STATION |
| FCA | FLANGED COUPLING ADAPTOR | T | TELEPHONE |
| FLG | FLANGED | W | WATER |
| G | GAS | W/ | WITH |
| GB | GRADE BRAKE | WP | WRAPPED |
| INV | INVERT ELEVATION | | |
| LF | LINEAL FEET | | |
| L | LAYOUT LINE | | |

SHEET INDEX

- TITLE SHEET
- 1. LOCATION MAPS & GENERAL NOTES
- 2. SHEET INDEX, LEGEND & ABBREVIATIONS
- 3. PLAN & PROFILE
- 4. PLAN & PROFILE
- 5. MISC. DETAIL
- 6. MISC. DETAIL

IF SHEET IS LESS THAN 24"X36" IT IS A REDUCED PRINT. SCALE REDUCED ACCORDINGLY.

U:\STEN\PROJ\5AMBRO\0-53\RECORD\SH2.DGN

1/99	RECORD DRAWING		
NO.	DATE	DESCRIPTION	NO. DATE DESCRIPTION
REVISIONS			

DESIGNED BY: STL/MA
DRAWN BY: JW/NH
CHECKED BY: DHD

URS URS Consultants, Inc.
CONSULTING ENGINEERS
SACRAMENTO CALIFORNIA



JOB No. 62370

NEWMARK OU REMEDIAL DESIGN
NEWMARK GROUNDWATER
CONTAMINATION SUPERFUND SITE
NORTH PLANT TRANSMISSION PIPELINE

SHEET INDEX, LEGEND & ABBREVIATIONS

Scale: AS SHOWN Date: JULY 31, 1997 Dwg. No.: 2