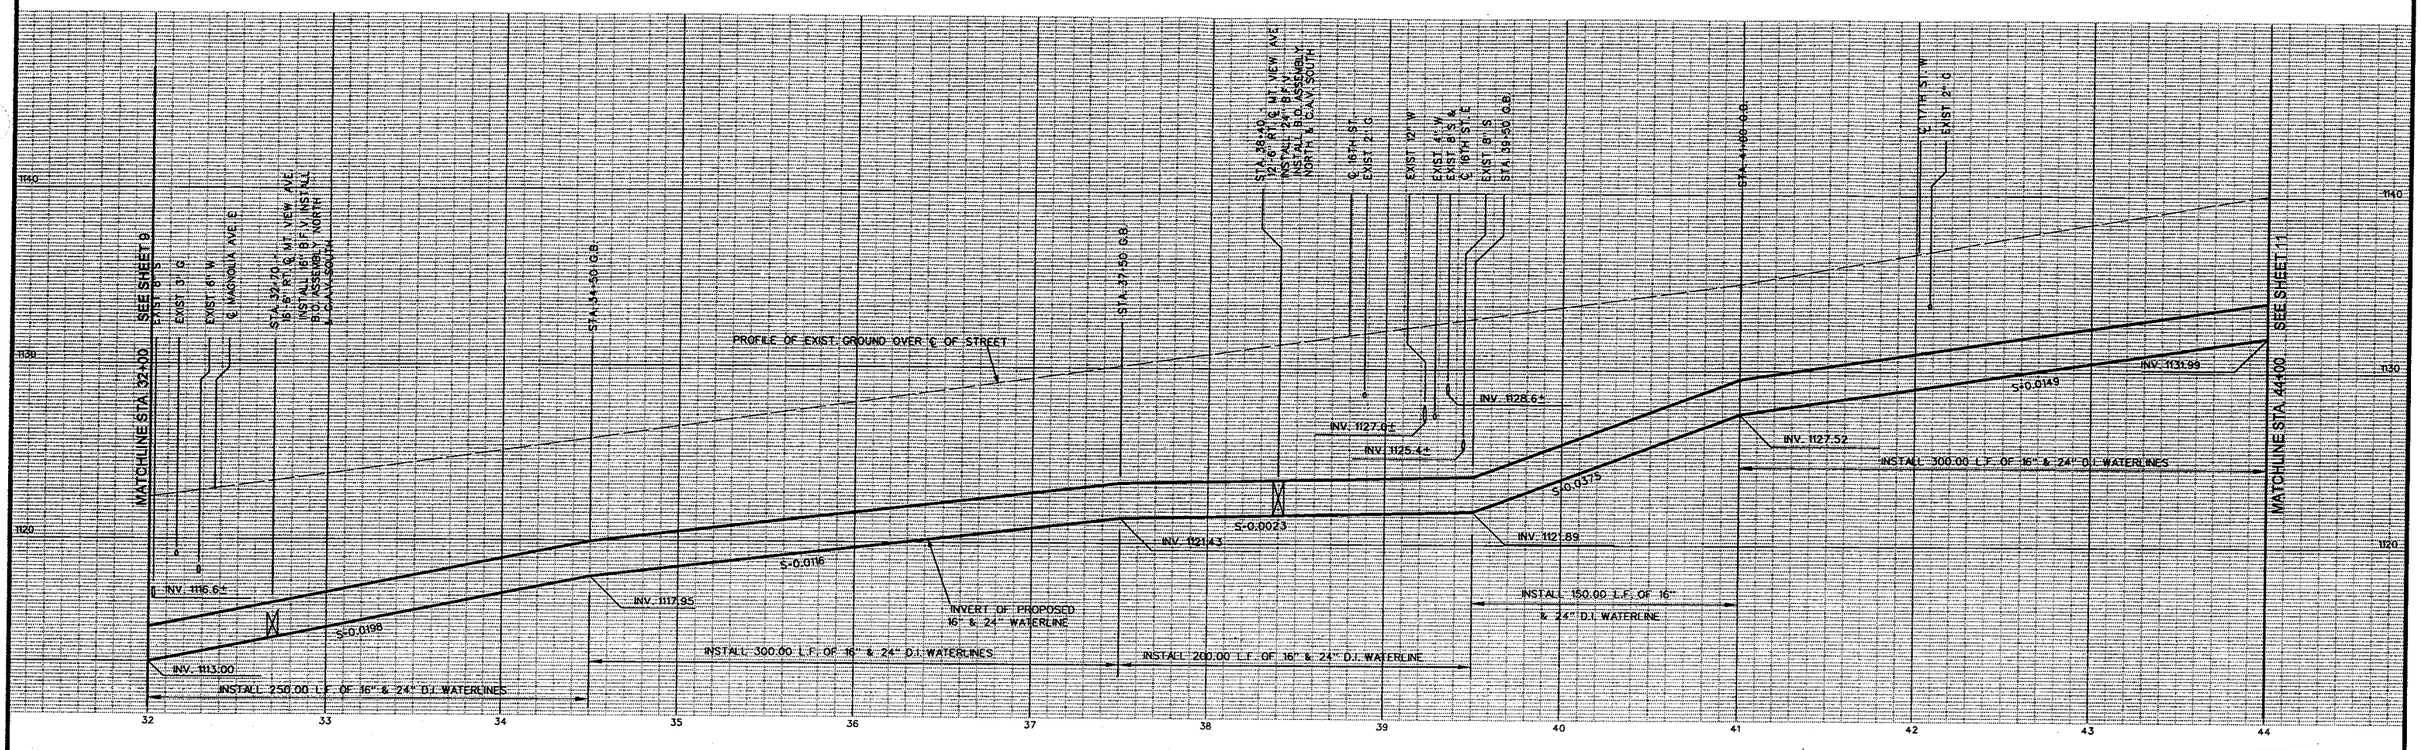

PROFILE SCALE
HORIZ. 1" = 40'
VERT. 1" = 4'

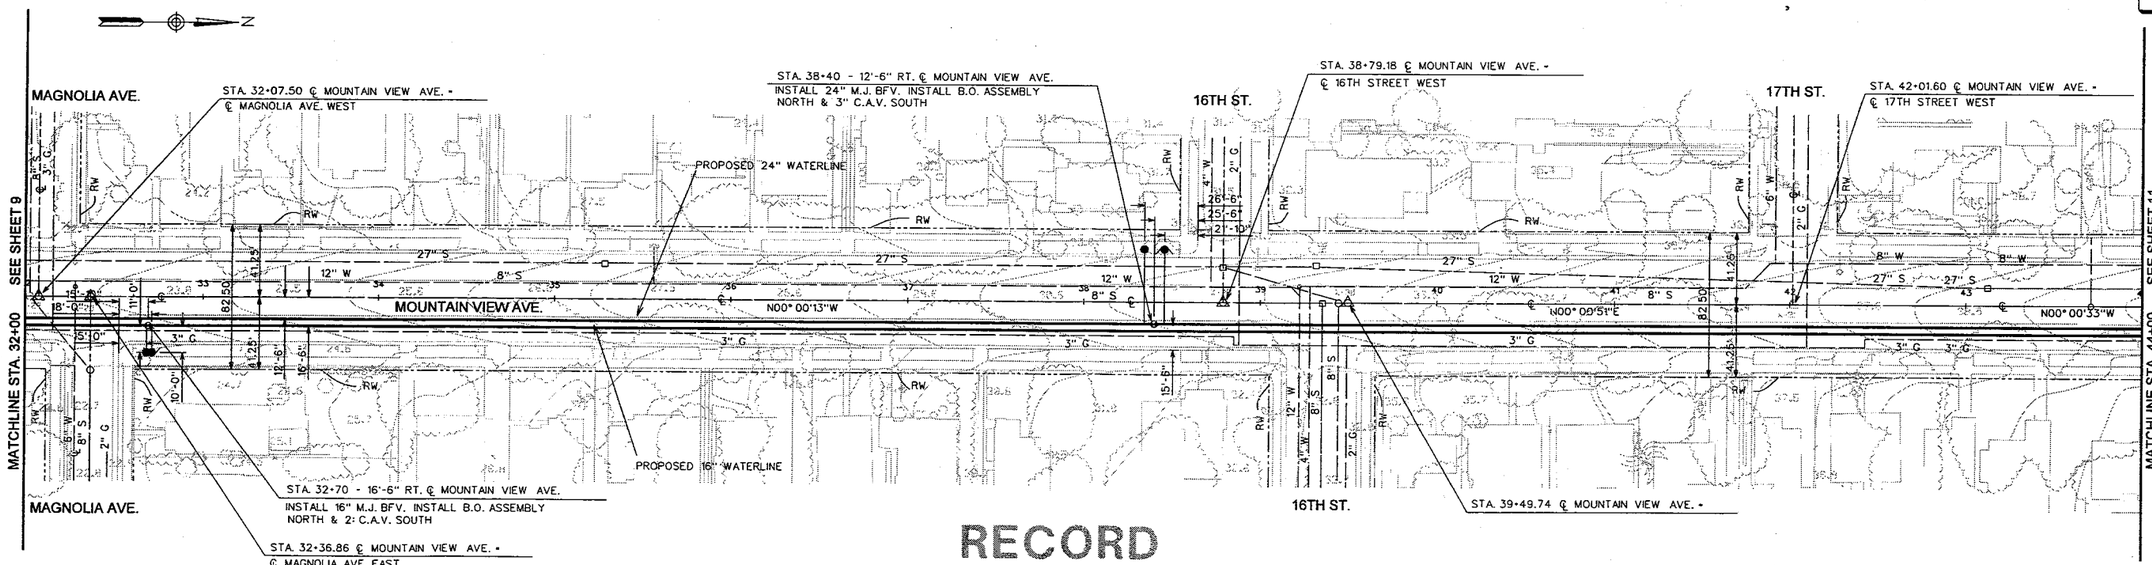

RECORD DRAWING

IF SHEET IS LESS THAN 24"X36" IT IS A REDUCED PRINT. SCALE REDUCED ACCORDINGLY.

NO.	DATE	DESCRIPTION	NO.	DATE	DESCRIPTION
	3/99	RECORD DRAWING			

REVISIONS

DESIGNED BY: STL
DRAWN BY: JW
CHECKED BY: DHD

URS Consultants, Inc.
CONSULTING ENGINEERS
SACRAMENTO CALIFORNIA

JOB No. 62370

REGISTERED PROFESSIONAL ENGINEER No. 34057 Norris E. Bentcher EXP. 6/30/98 CIVIL STATE OF CALIFORNIA

NEWMARK OU REMEDIAL DESIGN
NEWMARK GROUNDWATER
CONTAMINATION SUPERFUND SITE
SOUTH PLANT TRANSMISSION PIPELINE

PLAN AND PROFILE
MOUNTAIN VIEW AVE.
STA. 32+00 TO STA. 44+00

Scale: AS SHOWN | Date: 9/25/97 | Dwg. No.: 10

U:\ST5\PROJ\SANBRDG\RECORD\SHT10.DGN

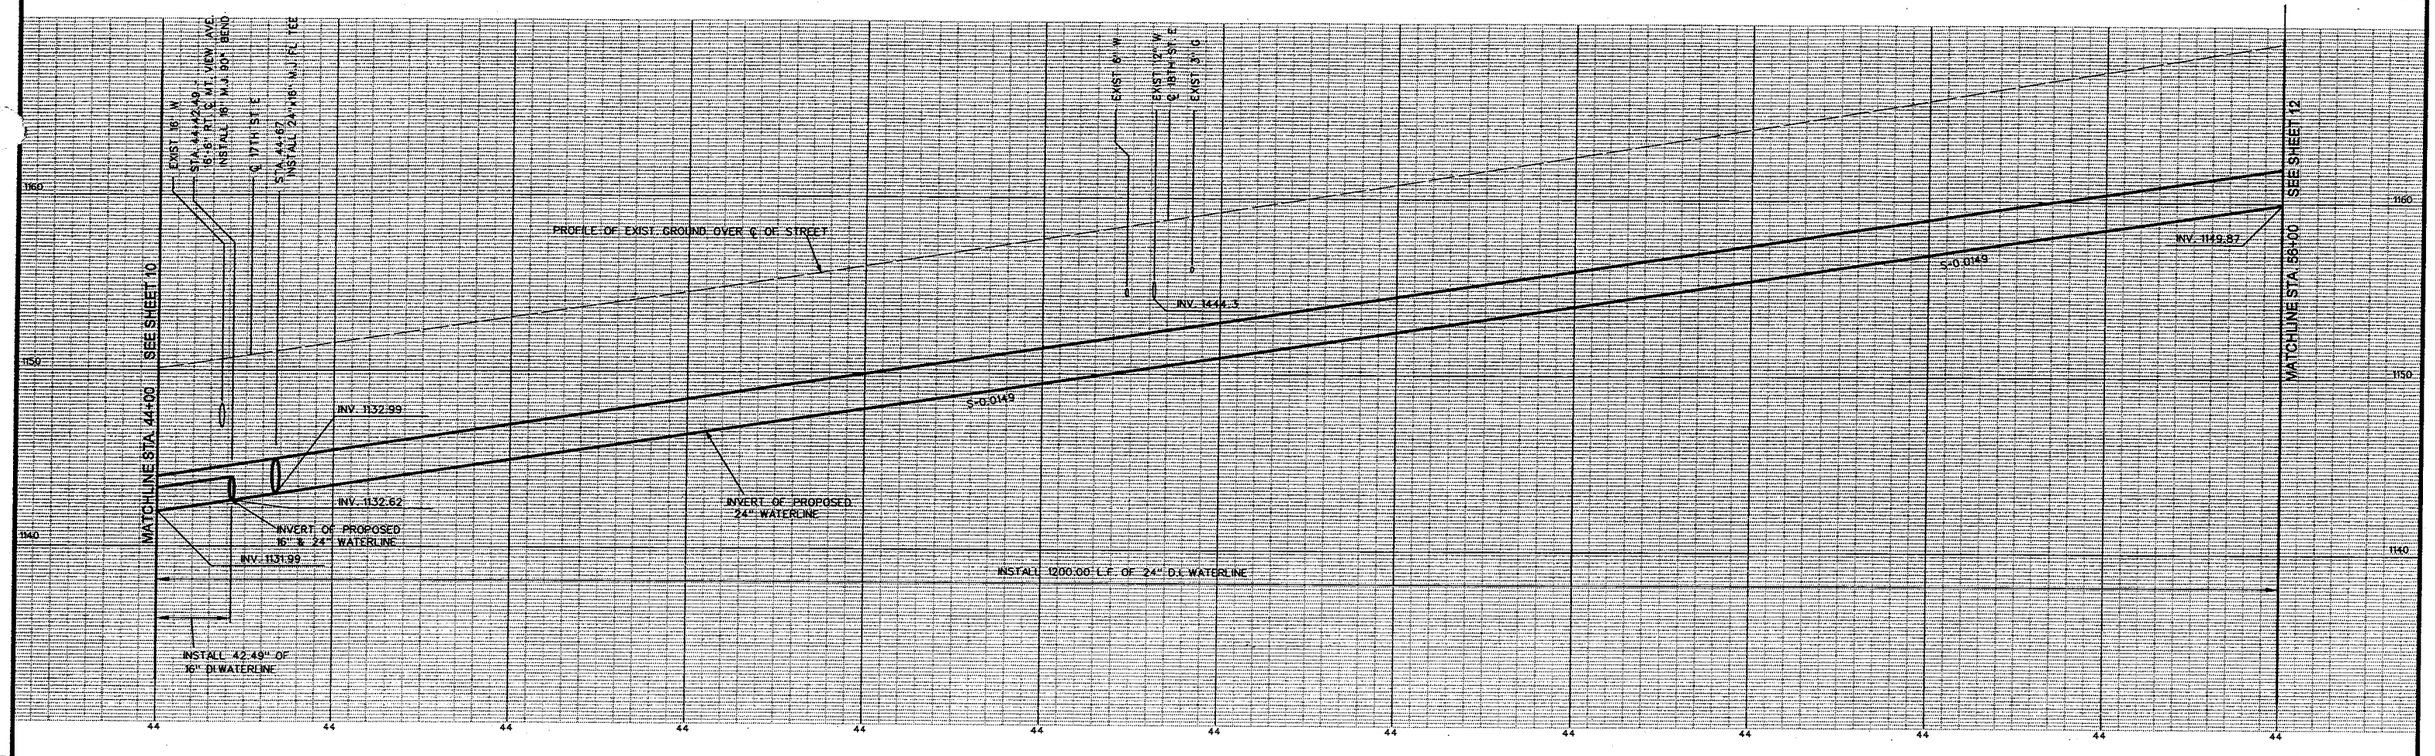

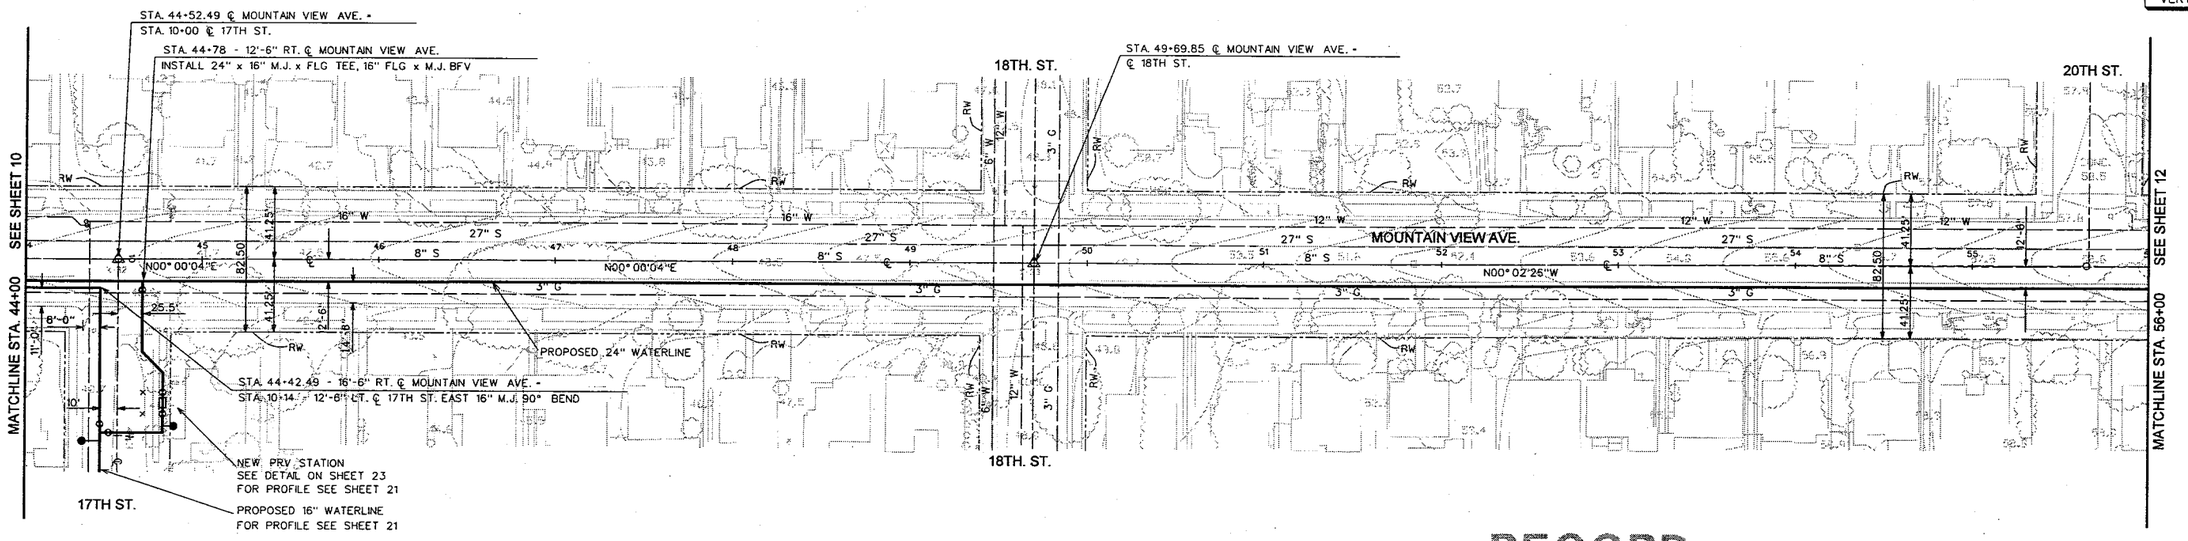

PROFILE SCALE
HORIZ. 1" = 40'
VERT. 1" = 4'

RECORD DRAWING

IF SHEET IS LESS THAN 24"X36" IT IS A REDUCED PRINT. SCALE REDUCED ACCORDINGLY.

NO.	DATE	DESCRIPTION	NO.	DATE	DESCRIPTION
	3/99	RECORD DRAWING			

REVISIONS

DESIGNED BY: STL
DRAWN BY: JW
CHECKED BY: DHO

URS Consultants, Inc.
CONSULTING ENGINEERS
SACRAMENTO CALIFORNIA

JOB No. 62370

REGISTERED PROFESSIONAL ENGINEER No. 34571 Eugene E. Sutcliffe EXP. 9/30/99 CIVIL STATE OF CALIFORNIA

NEWMARK OU REMEDIAL DESIGN
NEWMARK GROUNDWATER
CONTAMINATION SUPERFUND SITE
SOUTH PLANT TRANSMISSION PIPELINE

PLAN AND PROFILE
MOUNTAIN VIEW AVE.
STA. 44+00 TO STA. 56+00

Scale: AS SHOWN | Date: 9/25/97 | Dwg. No.: 11

U:\ST5\PROJ\SANBRDO\RECORD\SHT11.DGN