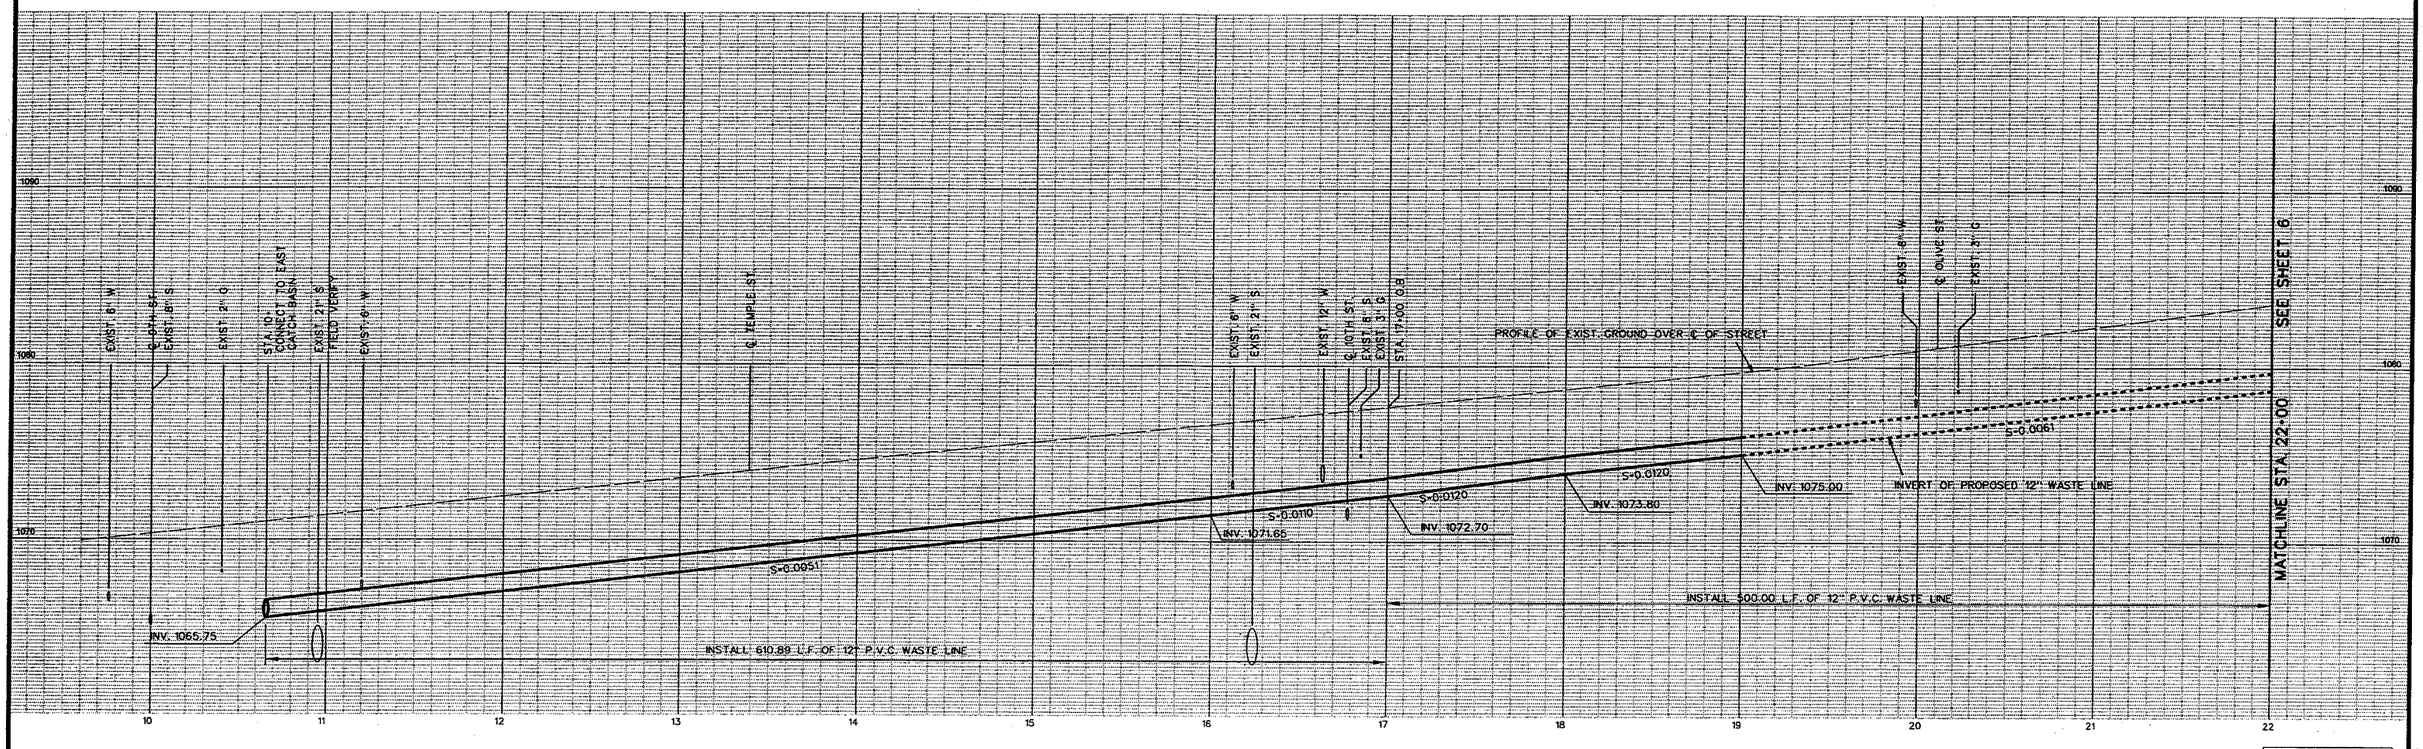

N

PROFILE SCALE
HORIZ. 1" = 40'
VERT. 1" = 4'

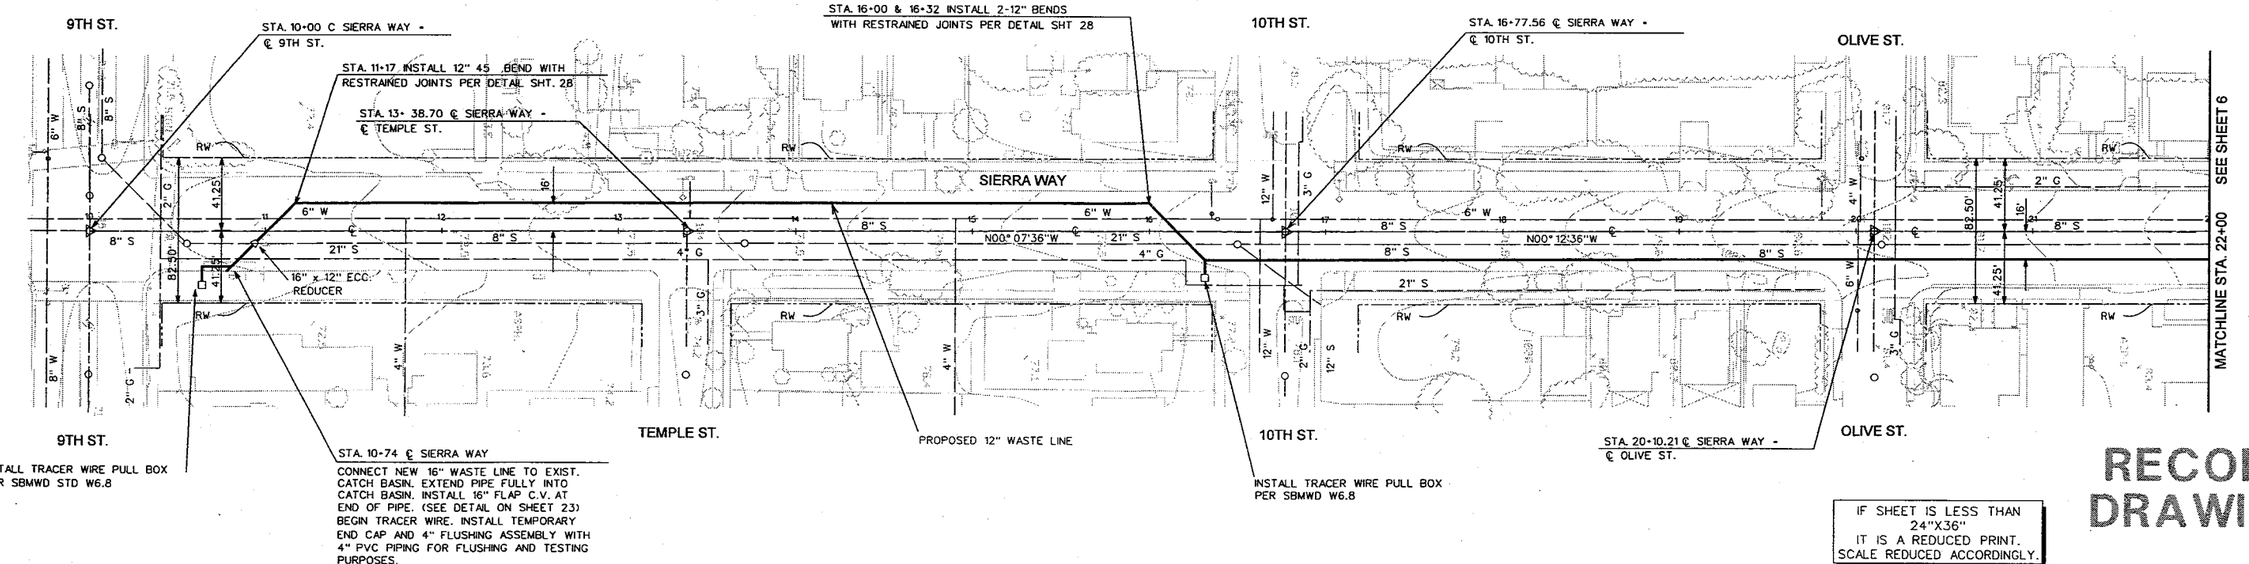

RECORD DRAWING

IF SHEET IS LESS THAN 24"X36" IT IS A REDUCED PRINT. SCALE REDUCED ACCORDINGLY.

NO.	DATE	DESCRIPTION	NO.	DATE	DESCRIPTION
	3/99	RECORD DRAWING			

REVISIONS

DESIGNED BY: STL
DRAWN BY: JW
CHECKED BY: DHD

URS Consultants, Inc.
CONSULTING ENGINEERS
SACRAMENTO CALIFORNIA

JOB No. 62370

REGISTERED PROFESSIONAL ENGINEER — No. 34551 — Wayne R. Deutscher — EXP. 9/30/99 — CIVIL — STATE OF CALIFORNIA

NEWMARK OU REMEDIAL DESIGN
NEWMARK GROUNDWATER
CONTAMINATION SUPERFUND SITE
SOUTH PLANT TRANSMISSION PIPELINE

PLAN AND PROFILE
SIERRA WAY
STA. 10+00 TO STA. 22+00

Scale: AS SHOWN | Date: 9/25/97 | Dwg. No.: 3

U:\ST5\PROJ\SANBRDO\RECORD\SHT3.DGN

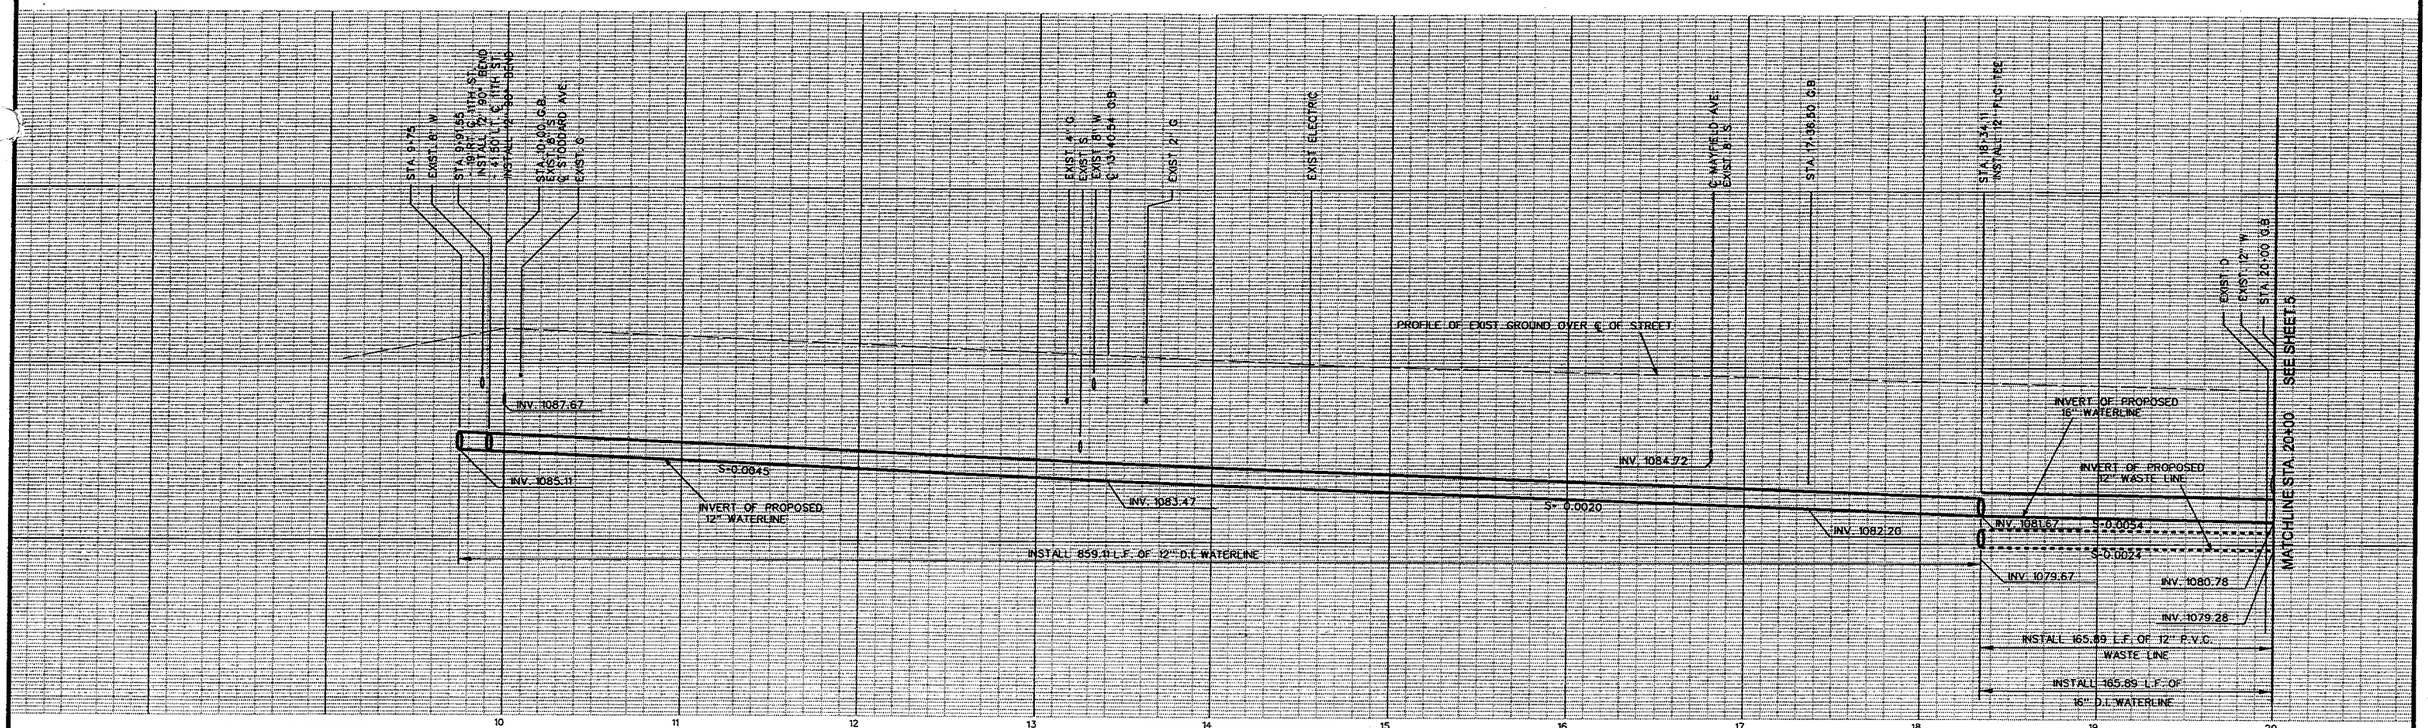

PROFILE SCALE
HORIZ. 1" = 40'
VERT. 1" = 4'

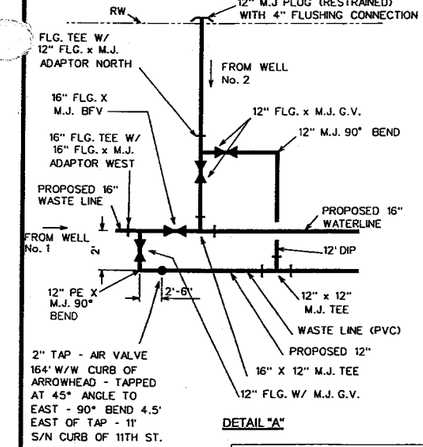

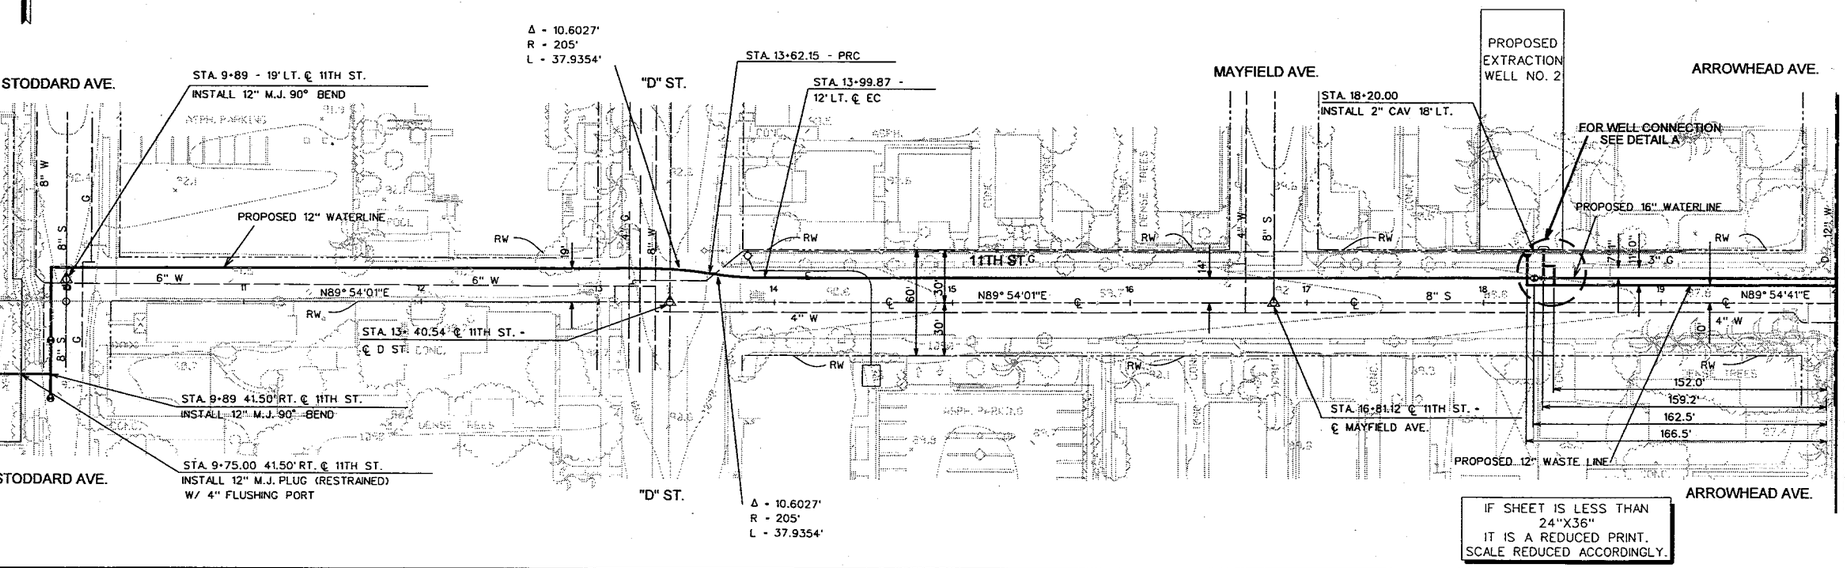

RECORD DRAWING

NOTES:
1. PIPELINE ALIGNMENT IS 6' EAST OF STODDARD AVE. WESTSIDE CURB
2. 45° ELBOWS LOCATED 20' & 22.9' WEST OF TEE AT STA. 9+89

IF SHEET IS LESS THAN 24"X36" IT IS A REDUCED PRINT. SCALE REDUCED ACCORDINGLY.

NO.	DATE	DESCRIPTION	NO.	DATE	DESCRIPTION
	3/99	RECORD DRAWING			

REVISIONS

DESIGNED BY: STL
DRAWN BY: JW
CHECKED BY: DHD

URS Consultants, Inc.
CONSULTING ENGINEERS
SACRAMENTO CALIFORNIA

JOB No. 62370

REGISTERED PROFESSIONAL ENGINEER No. 34557 George H. Deutsche CIVIL STATE OF CALIFORNIA

NEWMARK OU REMEDIAL DESIGN
NEWMARK GROUNDWATER CONTAMINATION SUPERFUND SITE
SOUTH PLANT TRANSMISSION PIPELINE

PLAN AND PROFILE
11TH ST.
STA. 10+00 TO 20+00

Scale: AS SHOWN | Date: 9/25/97 | Dwg. No.: 4

U:\ST5\PROJ\SANBRDO\RECORD\SHT4.DGN