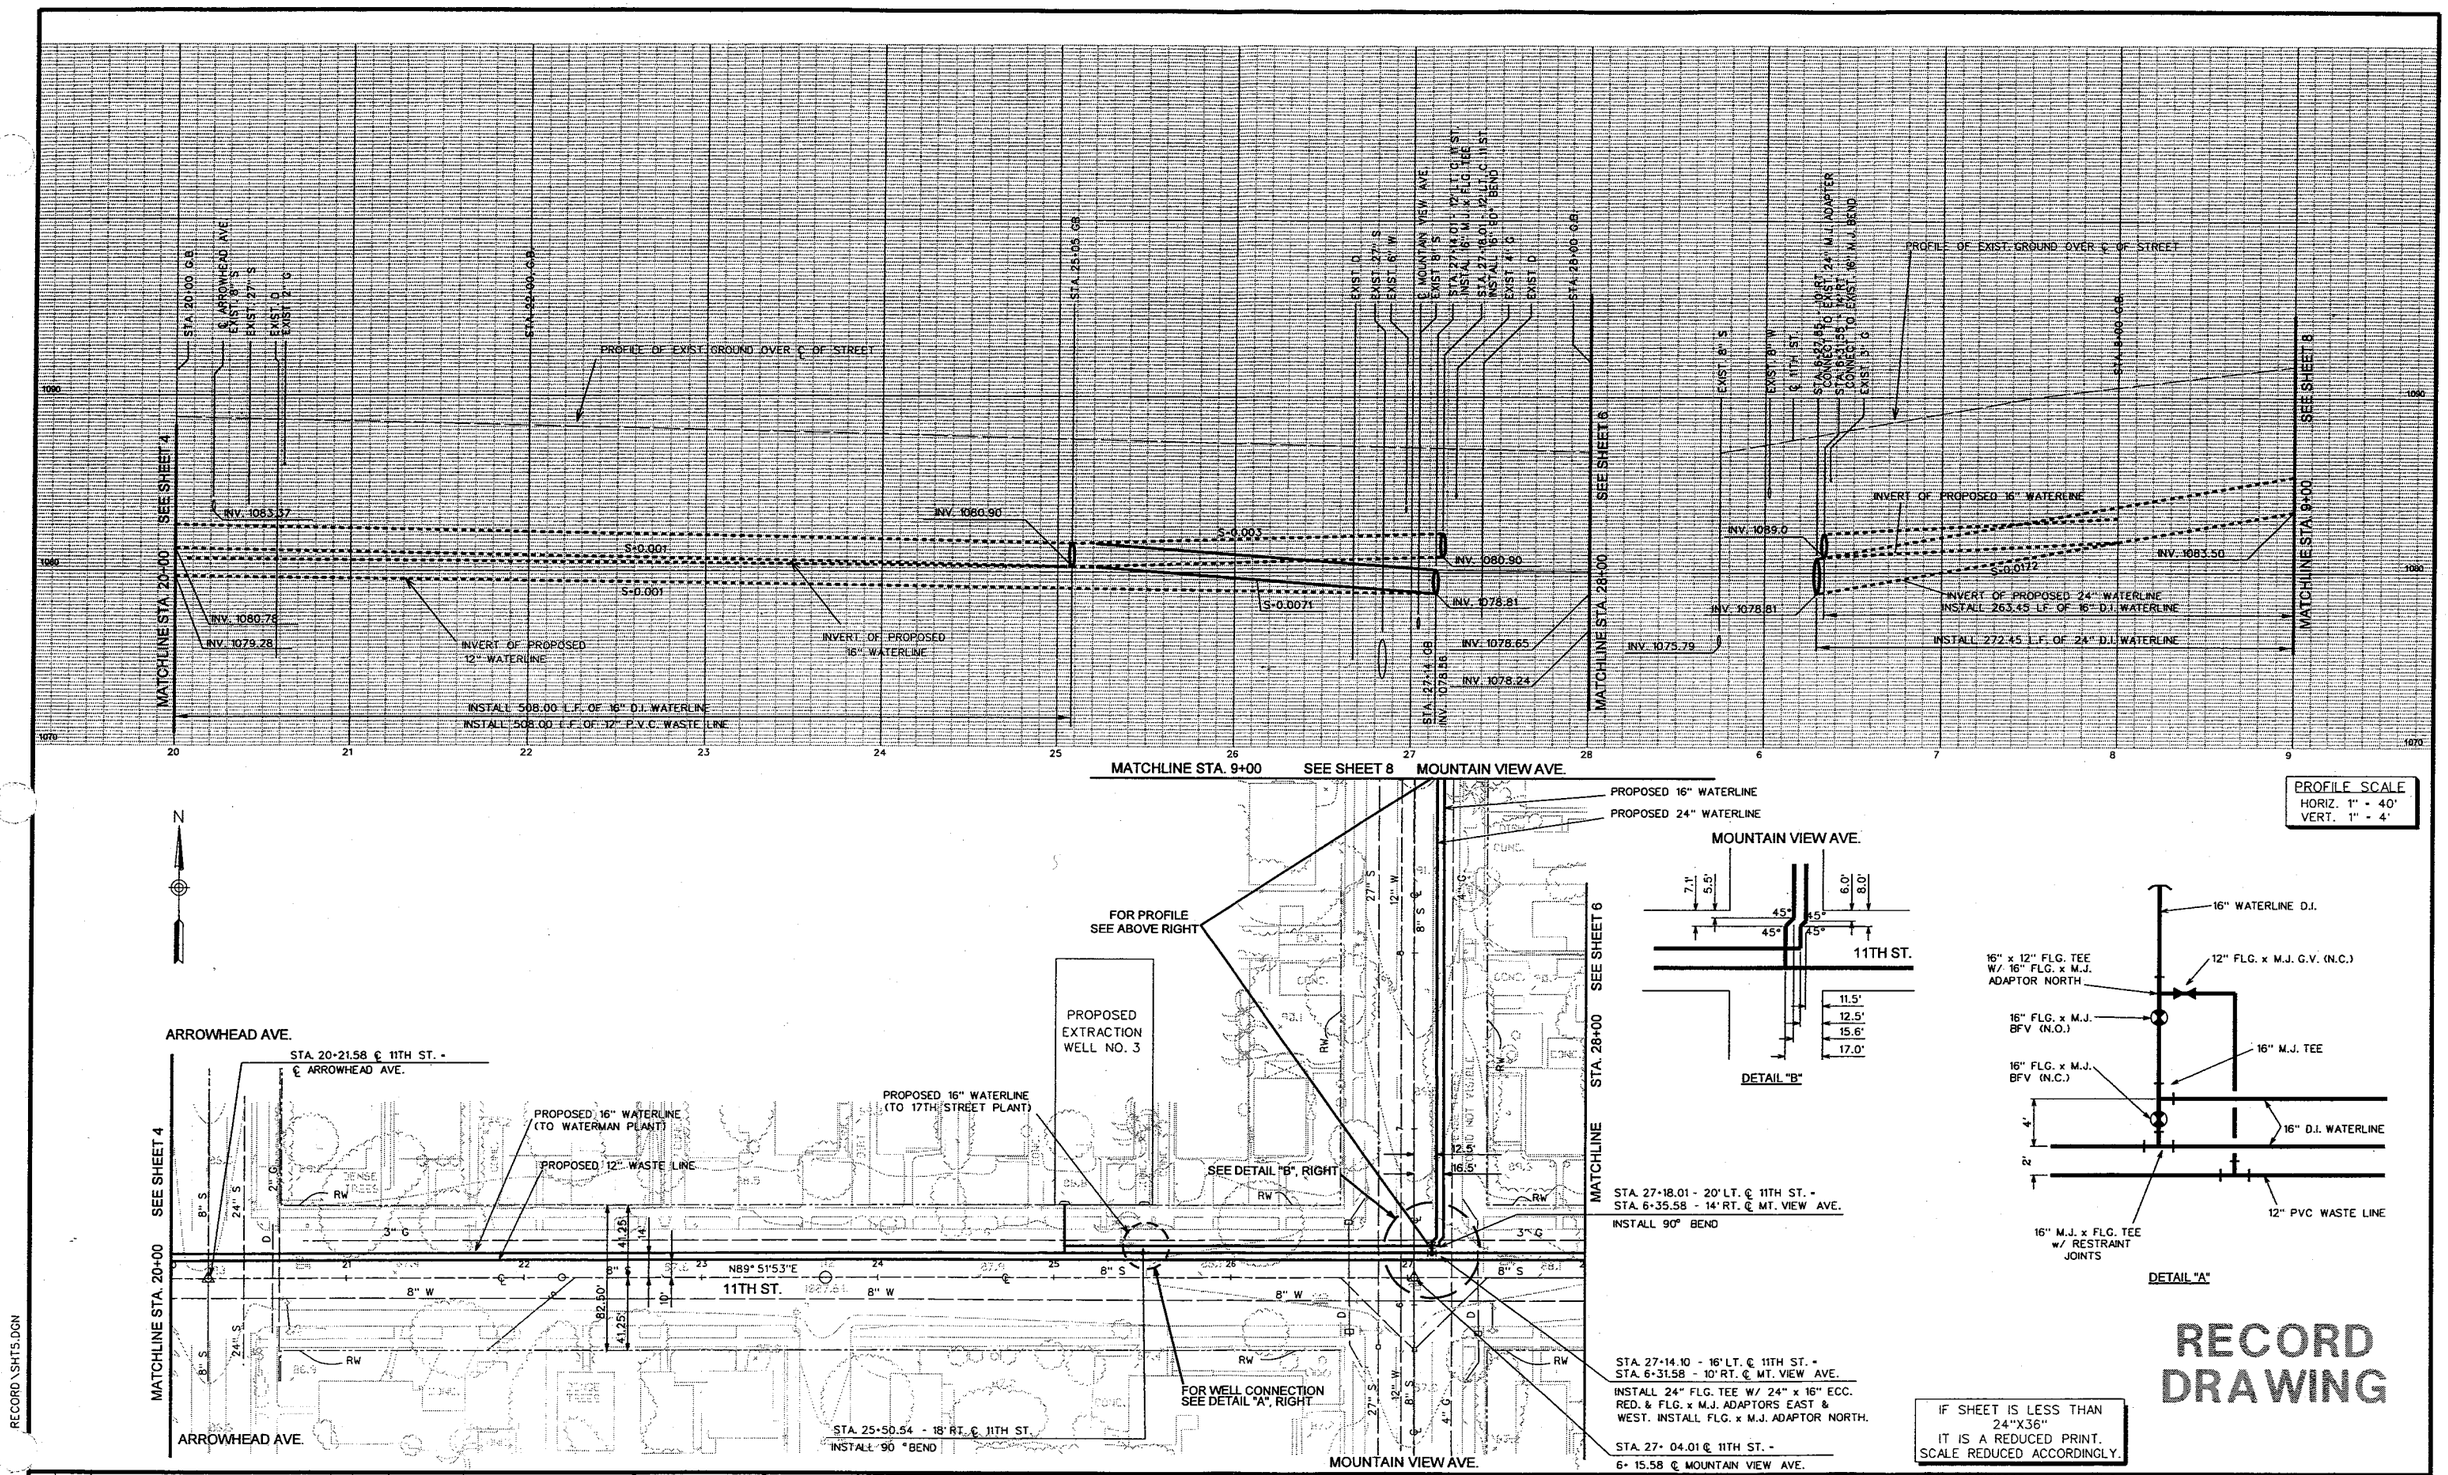

PROFILE SCALE
HORIZ. 1" = 40'
VERT. 1" = 4'

RECORD DRAWING

IF SHEET IS LESS THAN 24"X36" IT IS A REDUCED PRINT. SCALE REDUCED ACCORDINGLY.

RECORD\SHTS.DGN

USTS\PROJ\SANBRDG

NO.	DATE	DESCRIPTION	NO.	DATE	DESCRIPTION
	3/99	RECORD DRAWING			

REVISIONS

DESIGNED BY: STL
DRAWN BY: JW
CHECKED BY: DHD

URS — URS Consultants, Inc. CONSULTING ENGINEERS SACRAMENTO CALIFORNIA

JOB No. 62370

REGISTERED PROFESSIONAL ENGINEER No. 34557 Gregory N. Bauchelet EXP. 5/30/99 CIVIL STATE OF CALIFORNIA

NEWMARK OU REMEDIAL DESIGN
NEWMARK GROUNDWATER
CONTAMINATION SUPERFUND SITE
SOUTH PLANT TRANSMISSION PIPELINE

PLAN AND PROFILE
11TH ST.
STA. 20+00 TO STA. 28+00
MOUNTAIN VIEW AVE.
STA. 6+00 TO STA. 9+00

Scale: | Date: 9/25/97 | Dwg. No.: 5

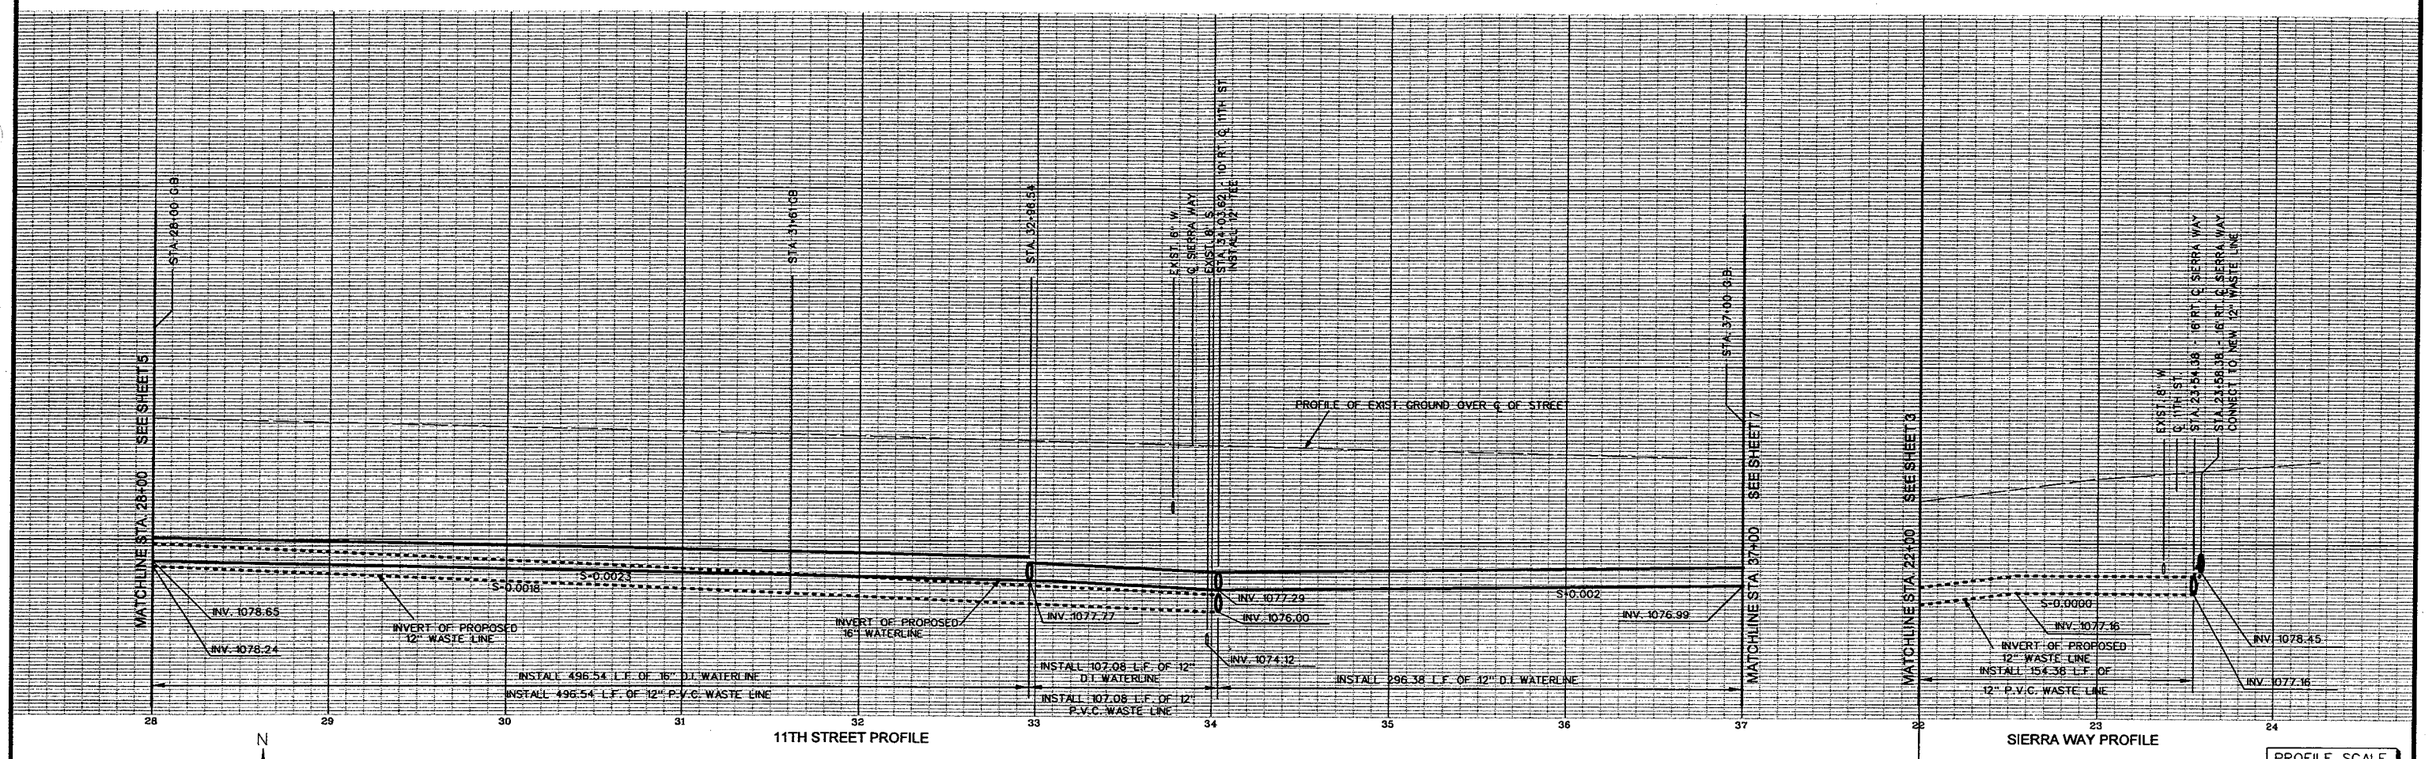

11TH STREET PROFILE

SIERRA WAY PROFILE

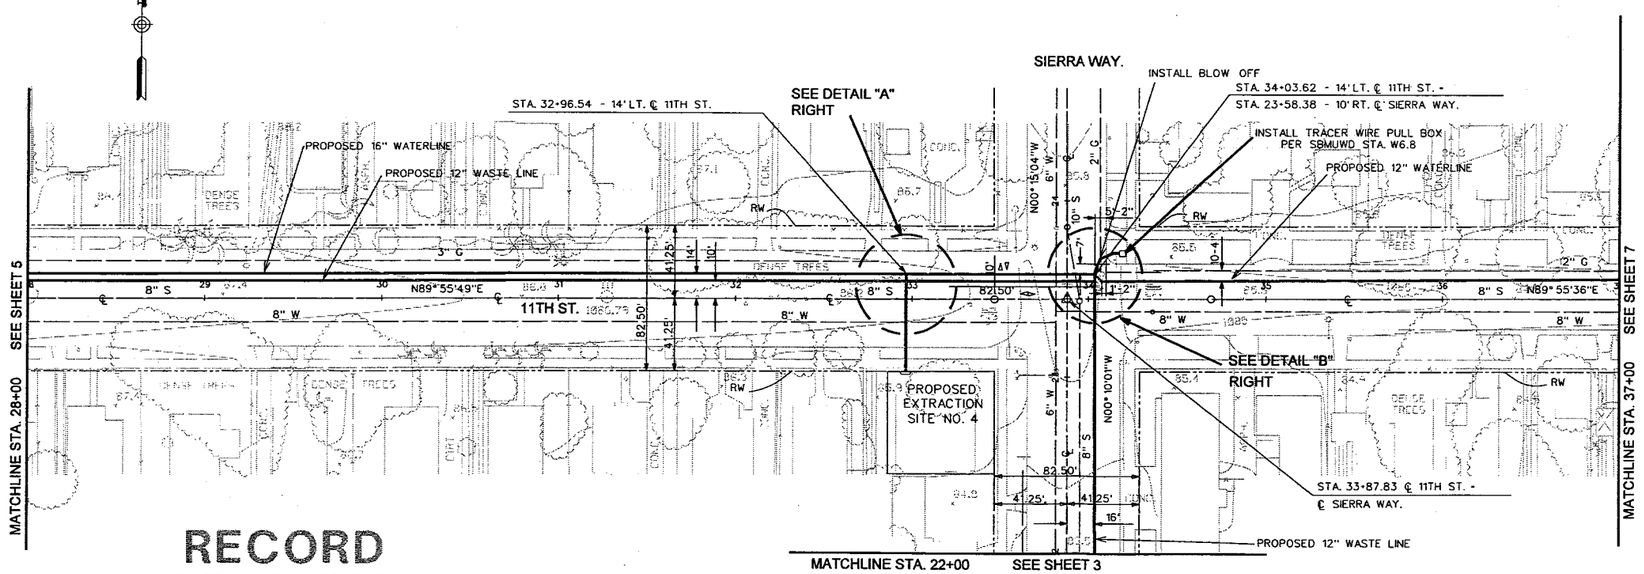

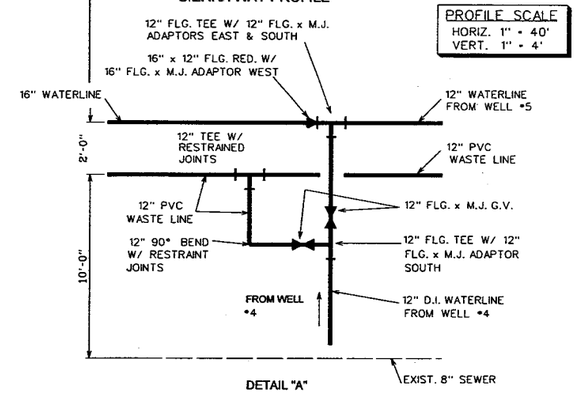

DETAIL "A"

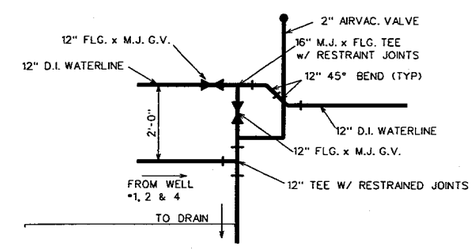

DETAIL "B"

RECORD DRAWING

IF SHEET IS LESS THAN 24"X36" IT IS A REDUCED PRINT. SCALE REDUCED ACCORDINGLY.

NO.	DATE	DESCRIPTION	NO.	DATE	DESCRIPTION
	3/99	RECORD DRAWING			

REVISIONS

DESIGNED BY: STL
DRAWN BY: JW
CHECKED BY: DHD

URS Consultants, Inc.
CONSULTING ENGINEERS
SACRAMENTO CALIFORNIA

JOB No. 62370

REGISTERED PROFESSIONAL ENGINEER No. 34557 Virginia G. Gaudreau EXP. 12/31/99 CIVIL STATE OF CALIFORNIA

NEWMARK OU REMEDIAL DESIGN
NEWMARK GROUNDWATER
CONTAMINATION SUPERFUND SITE
SOUTH PLANT TRANSMISSION PIPELINE

PLAN AND PROFILE
11TH ST.
STA. 28+00 TO STA. 37+00
SIERRA WAY
STA. 22+00 TO STA. 24+00

Scale: AS SHOWN | Date: 9/25/97 | Dwg. No.: 6

US75\PROJ\SANBRO...\RECORD\SHT6.DGN

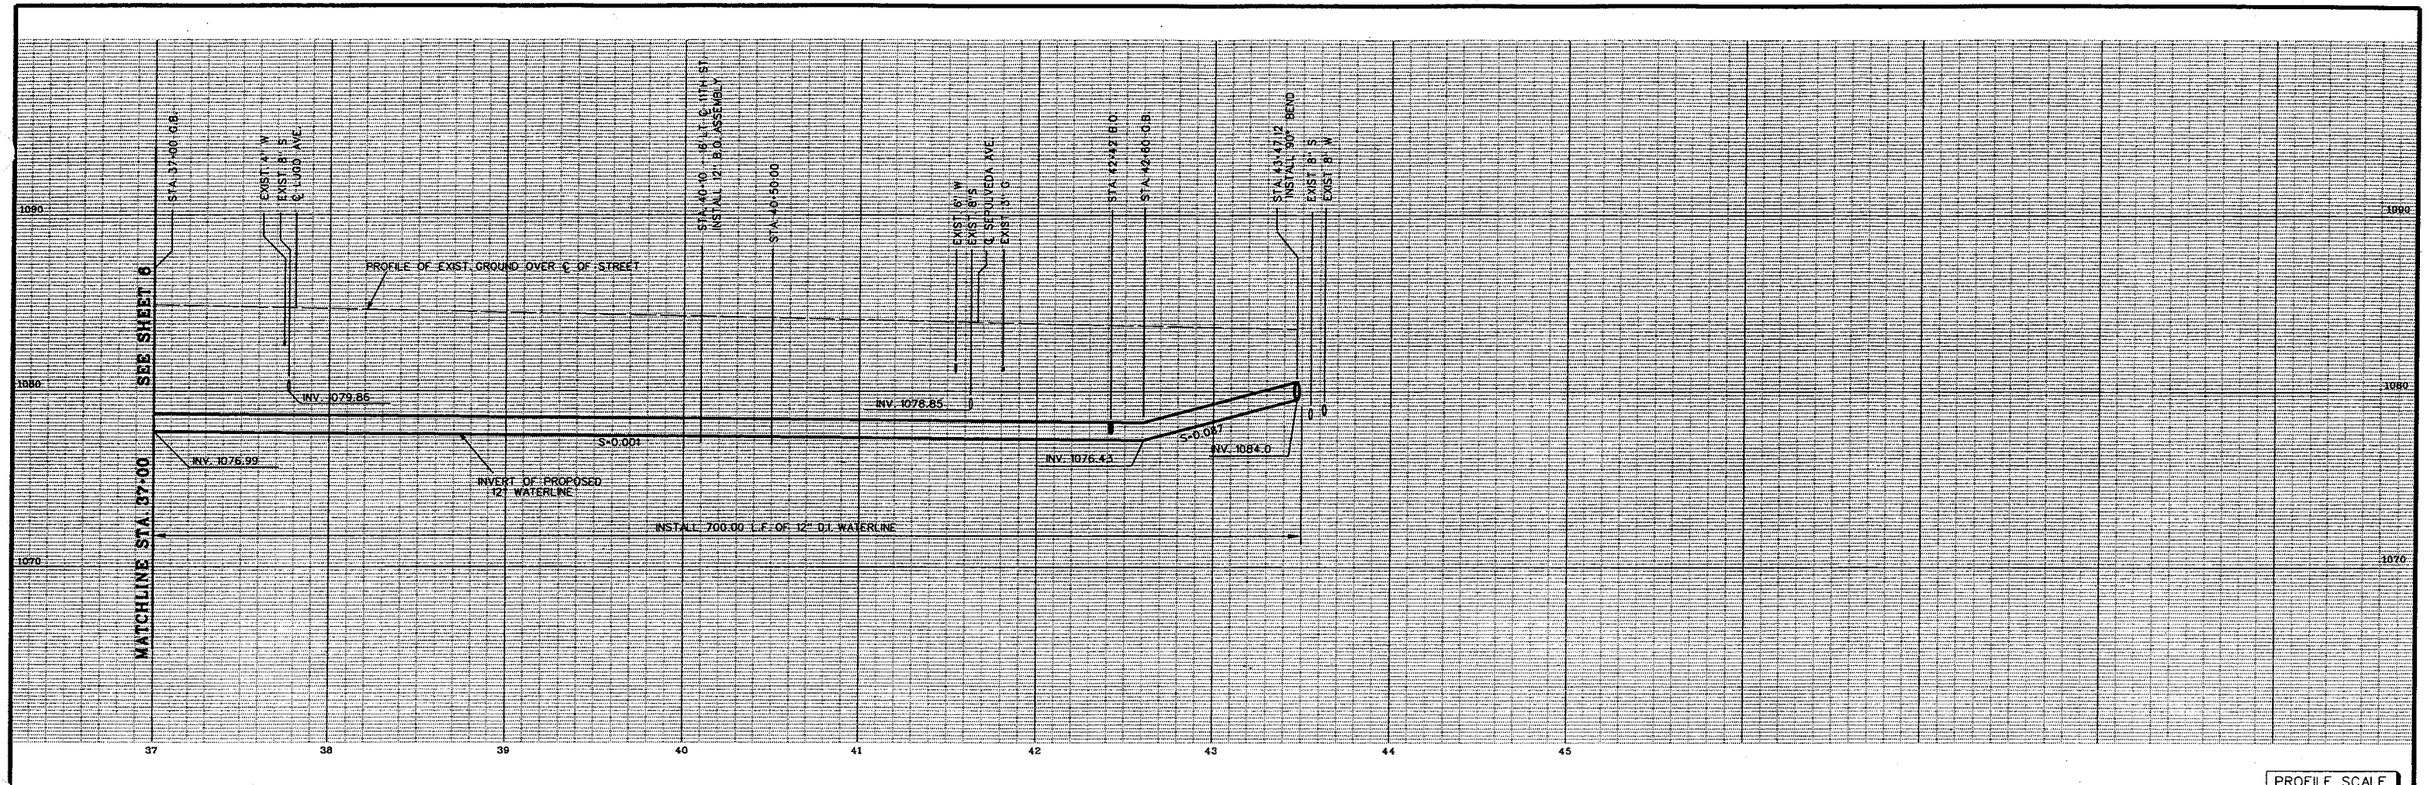

PROFILE SCALE
HORIZ. 1" = 40'
VERT. 1" = 4'

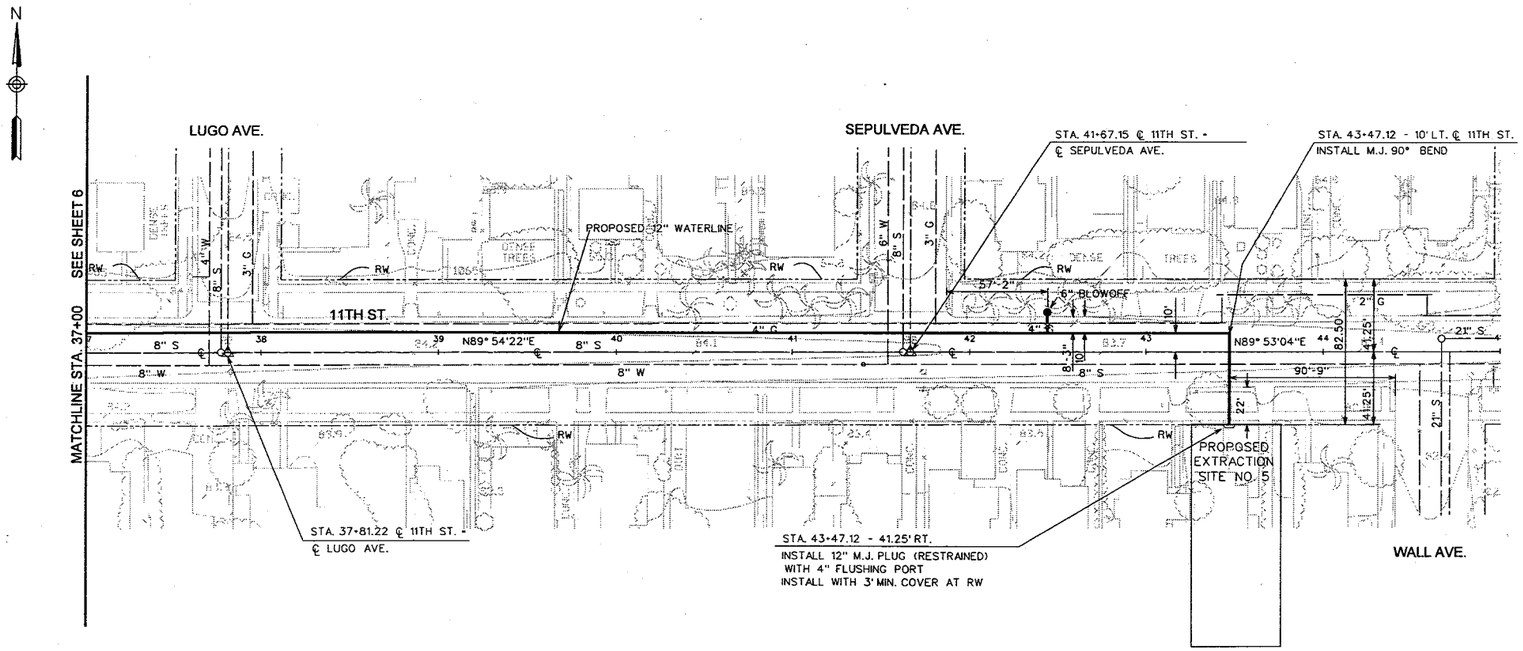

RECORD DRAWING

IF SHEET IS LESS THAN 24"X36" IT IS A REDUCED PRINT. SCALE REDUCED ACCORDINGLY.

NO.	DATE	DESCRIPTION	NO.	DATE	DESCRIPTION
	3/99	RECORD DRAWING			

REVISIONS

DESIGNED BY: STL
DRAWN BY: JW
CHECKED BY: DHD

URS Consultants, Inc.
CONSULTING ENGINEERS
SACRAMENTO CALIFORNIA

JOB No. 62370

NEWMARK OU REMEDIAL DESIGN
NEWMARK GROUNDWATER
CONTAMINATION SUPERFUND SITE
SOUTH PLANT TRANSMISSION PIPELINE

PLAN AND PROFILE
11TH ST.
STA. 37+00 TO STA. 43+47

Scale: AS SHOWN | Date: 9/25/97 | Dwg. No.: 7

UST5\PROJ\SANBRDO\RECORD\SHT7.DGN