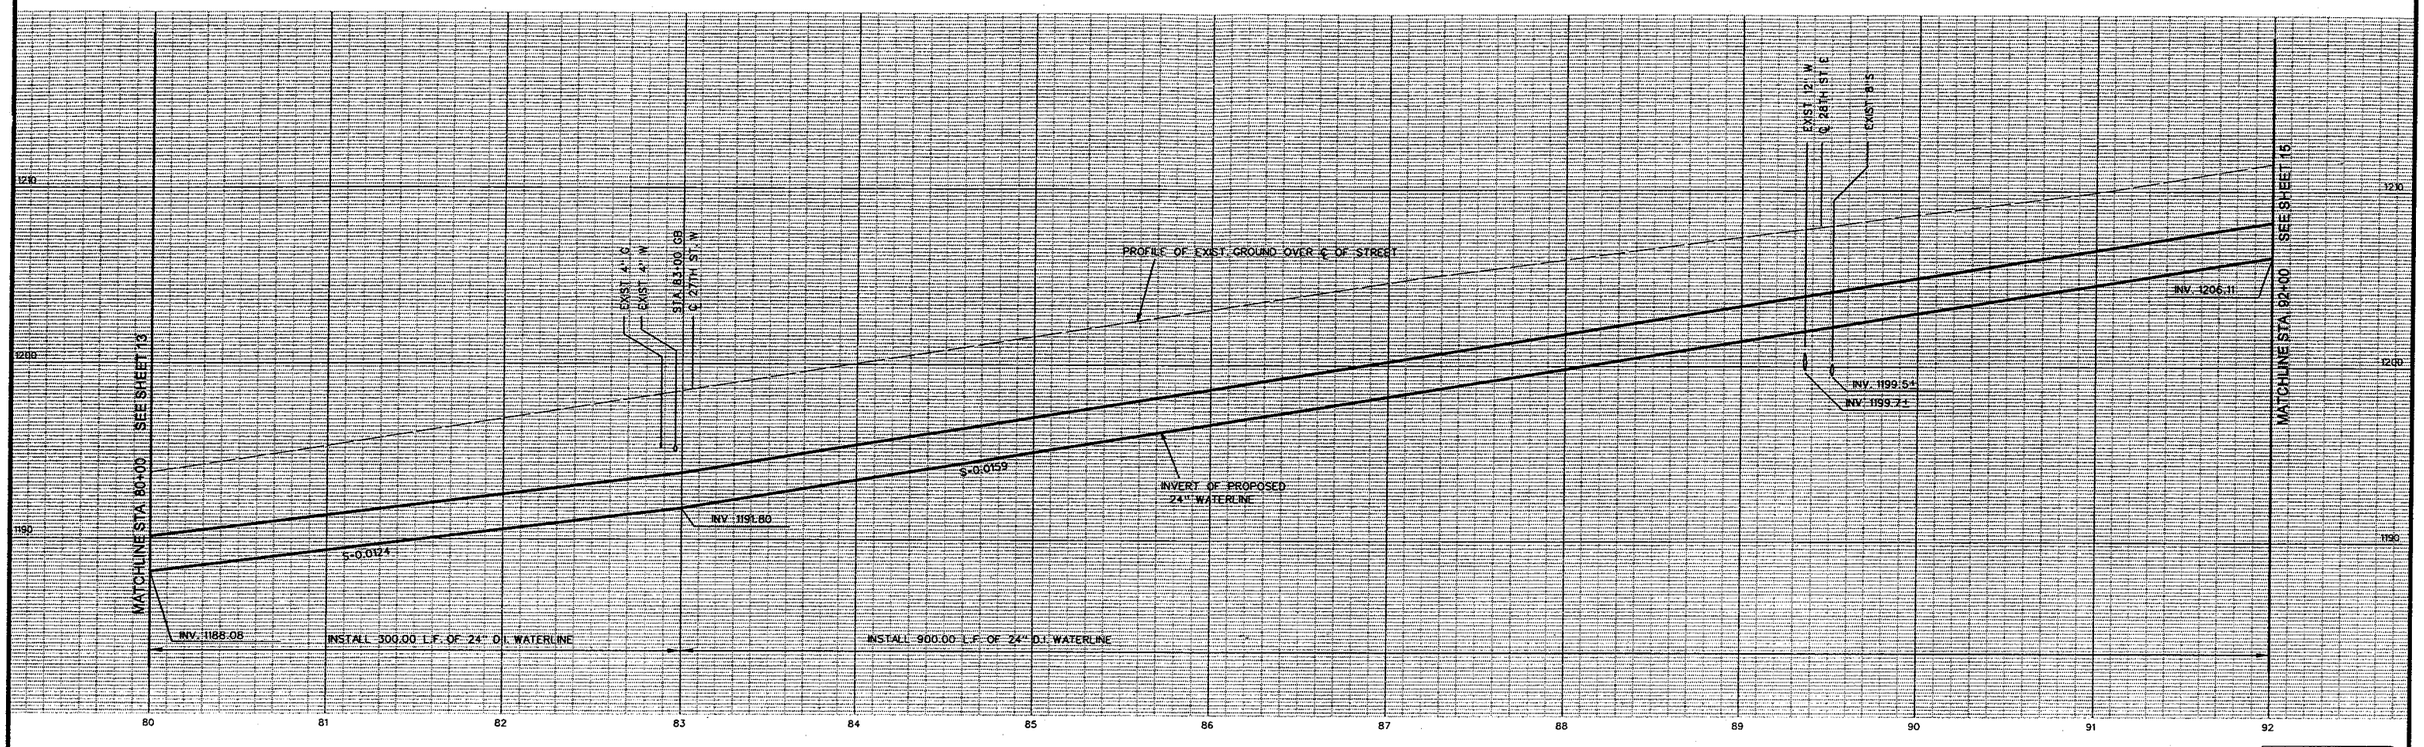

PROFILE SCALE
HORIZ. 1" = 40'
VERT. 1" = 4'

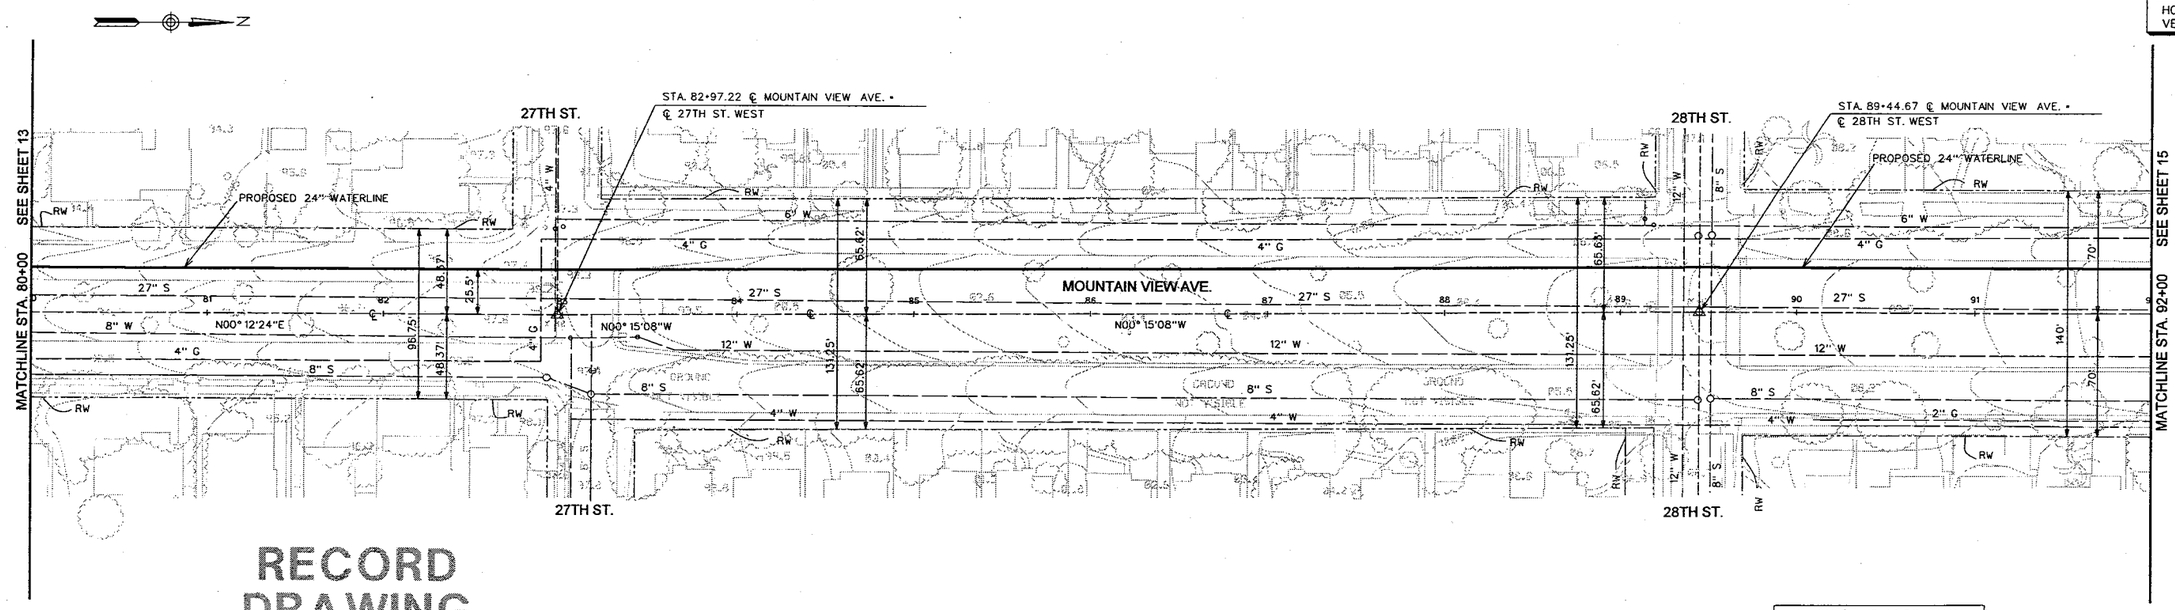

RECORD DRAWING

IF SHEET IS LESS THAN 24"X36" IT IS A REDUCED PRINT. SCALE REDUCED ACCORDINGLY.

NO.	DATE	DESCRIPTION	NO.	DATE	DESCRIPTION
	3/99	RECORD DRAWING			

REVISIONS

DESIGNED BY: STL
DRAWN BY: JW
CHECKED BY: DHD

URS Consultants, Inc.
CONSULTING ENGINEERS
SACRAMENTO CALIFORNIA

JOB No. 62370

REGISTERED PROFESSIONAL ENGINEER No. 34557 Virginia R. Dutcher Exp. 3/30/99 CIVIL STATE OF CALIFORNIA

NEWMARK OU REMEDIAL DESIGN
NEWMARK GROUNDWATER
CONTAMINATION SUPERFUND SITE
SOUTH PLANT TRANSMISSION PIPELINE

PLAN AND PROFILE
MOUNTAIN VIEW AVE.
STA. 80+00 TO 92+00

Scale: AS SHOWN | Date: 9/25/97 | Dwg. No.: 14

U:\ST5\PROJ\SANBRDO\RECORD\SHT14.DGN

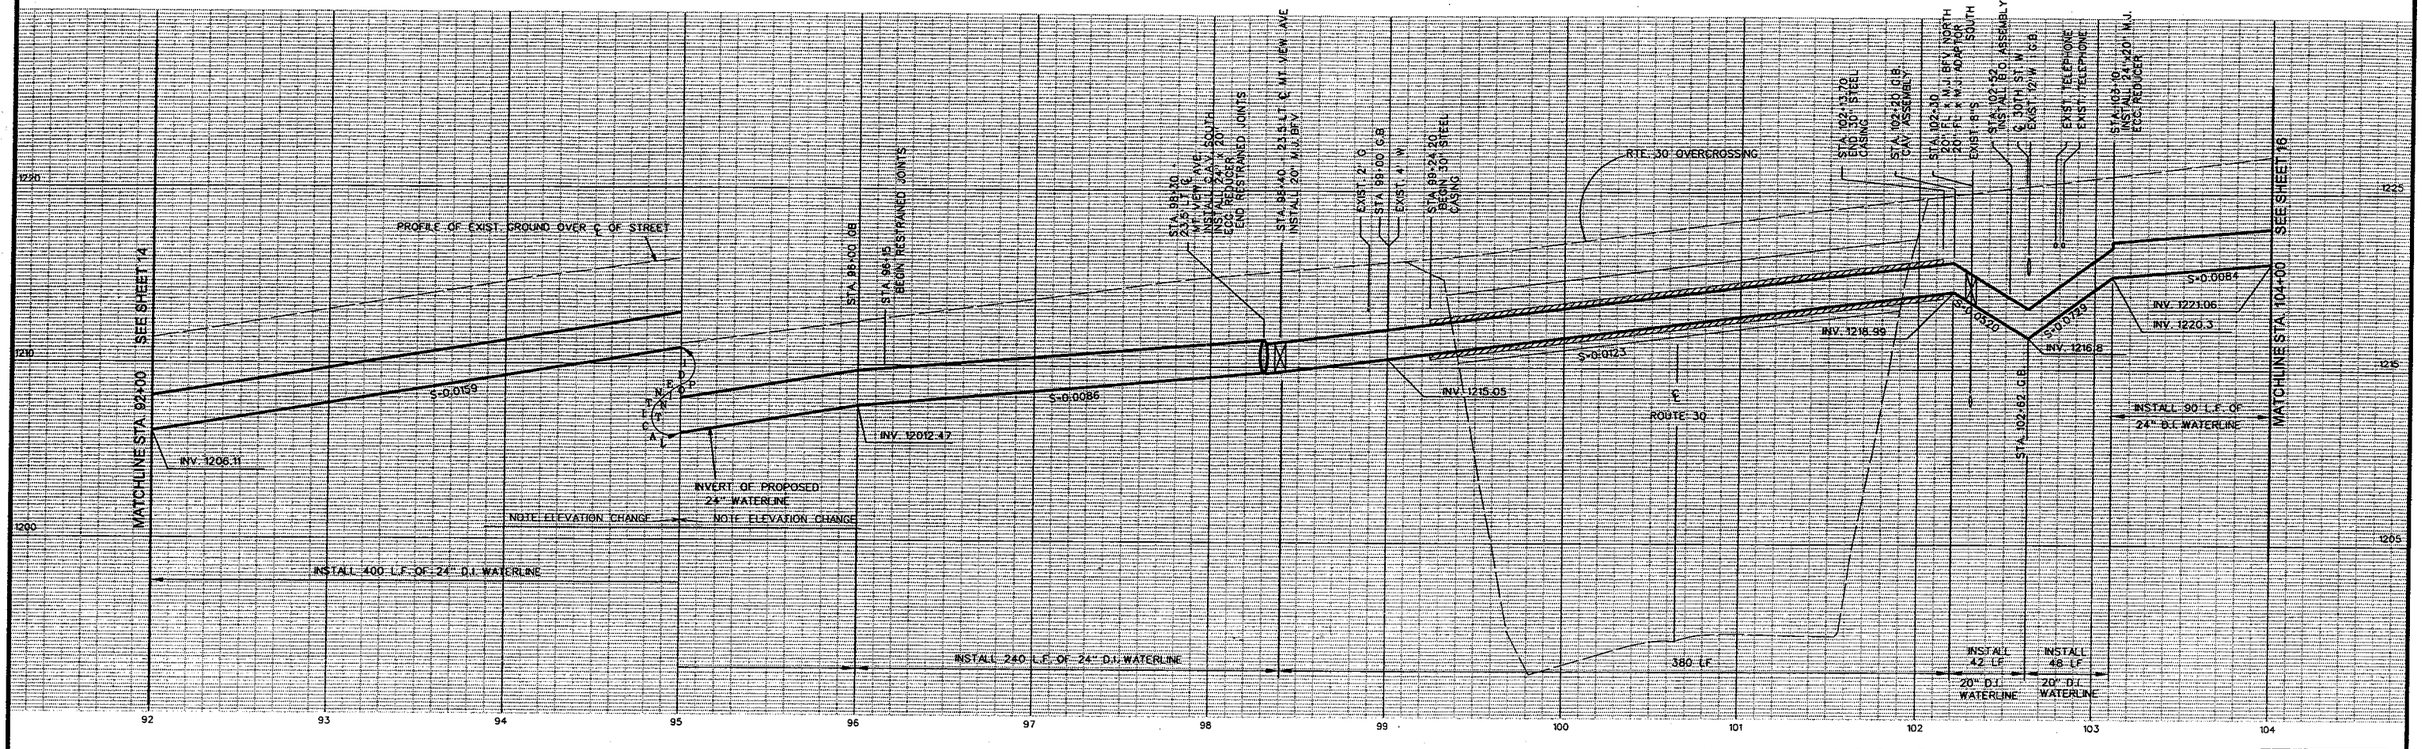

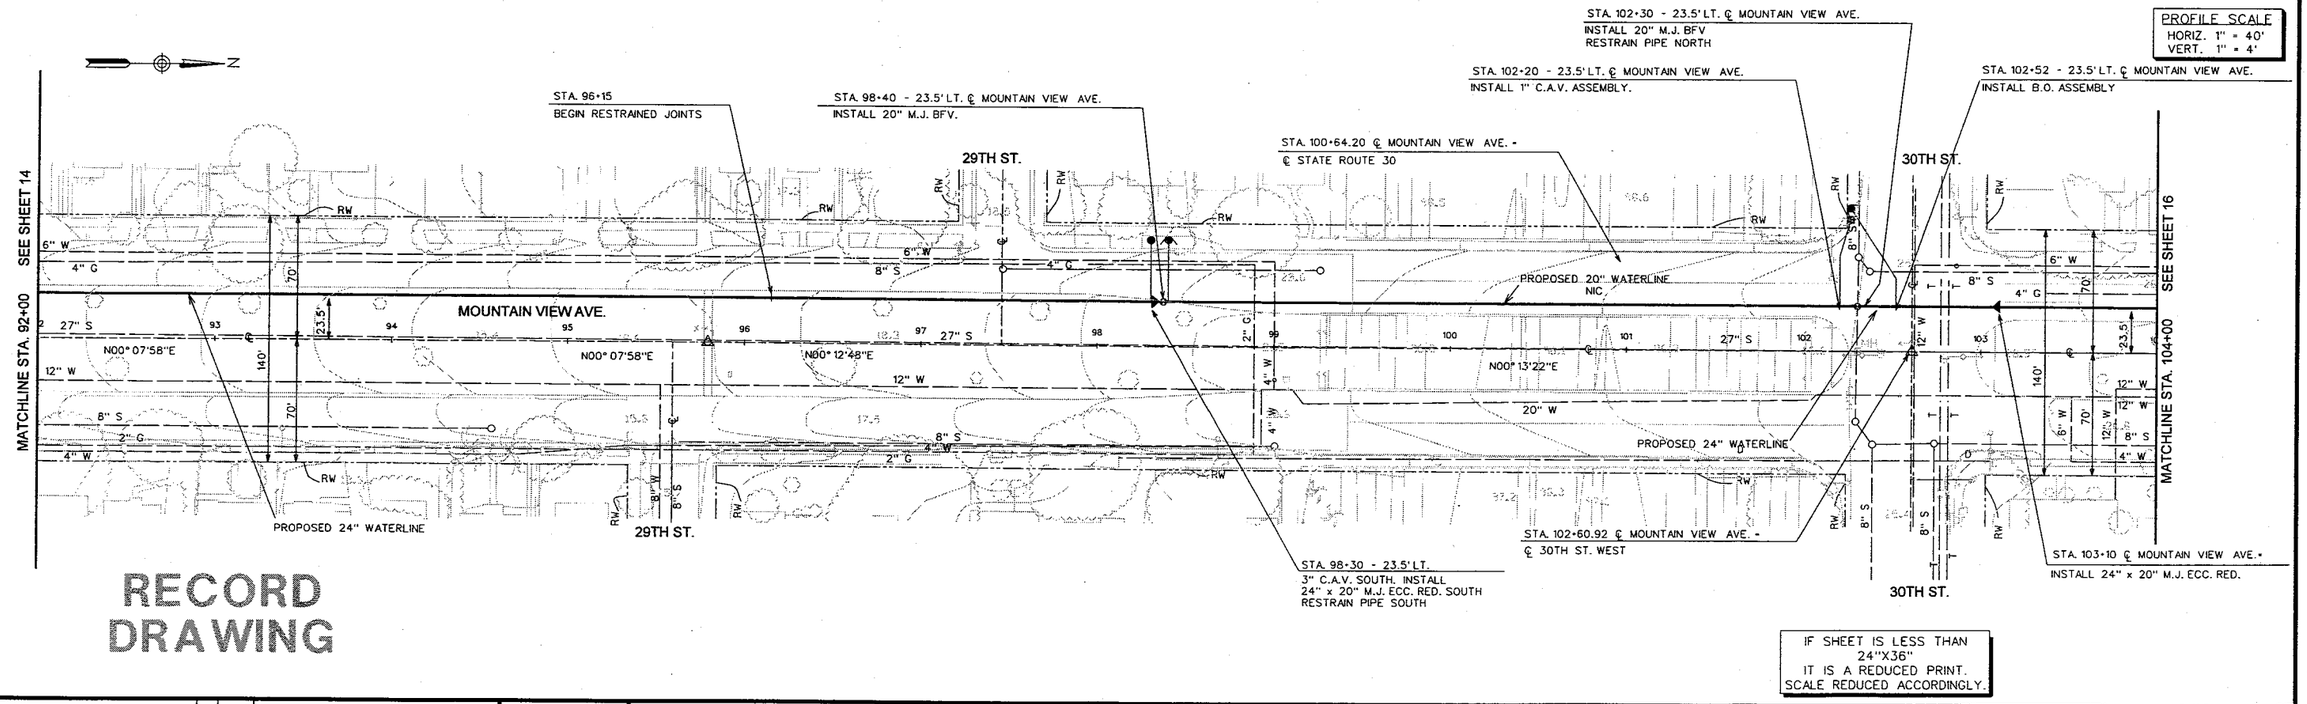

PROFILE SCALE
HORIZ. 1" = 40'
VERT. 1" = 4'

RECORD DRAWING

IF SHEET IS LESS THAN 24"X36" IT IS A REDUCED PRINT. SCALE REDUCED ACCORDINGLY.

NO.	DATE	DESCRIPTION	NO.	DATE	DESCRIPTION
	3/99	RECORD DRAWING			

REVISIONS

DESIGNED BY: STL
DRAWN BY: JW
CHECKED BY: DHD

URS Consultants, Inc.
CONSULTING ENGINEERS
SACRAMENTO CALIFORNIA

JOB No. 62370

REGISTERED PROFESSIONAL ENGINEER No. 34557 Eugene R. Daubachs EXP. 9/30/99 CIVIL STATE OF CALIFORNIA

NEWMARK OU REMEDIAL DESIGN
NEWMARK GROUNDWATER
CONTAMINATION SUPERFUND SITE
SOUTH PLANT TRANSMISSION PIPELINE

PLAN AND PROFILE
MOUNTAIN VIEW AVE.
STA. 92+00 TO 104+00

Scale: AS SHOWN | Date: 9/25/97 | Dwg. No.: 15

U:\ST15\PROJ\SANBRDO \RECORD\SHT15.DGN