APPENDIX A

AS-BUILT DRAWING OF WELLS

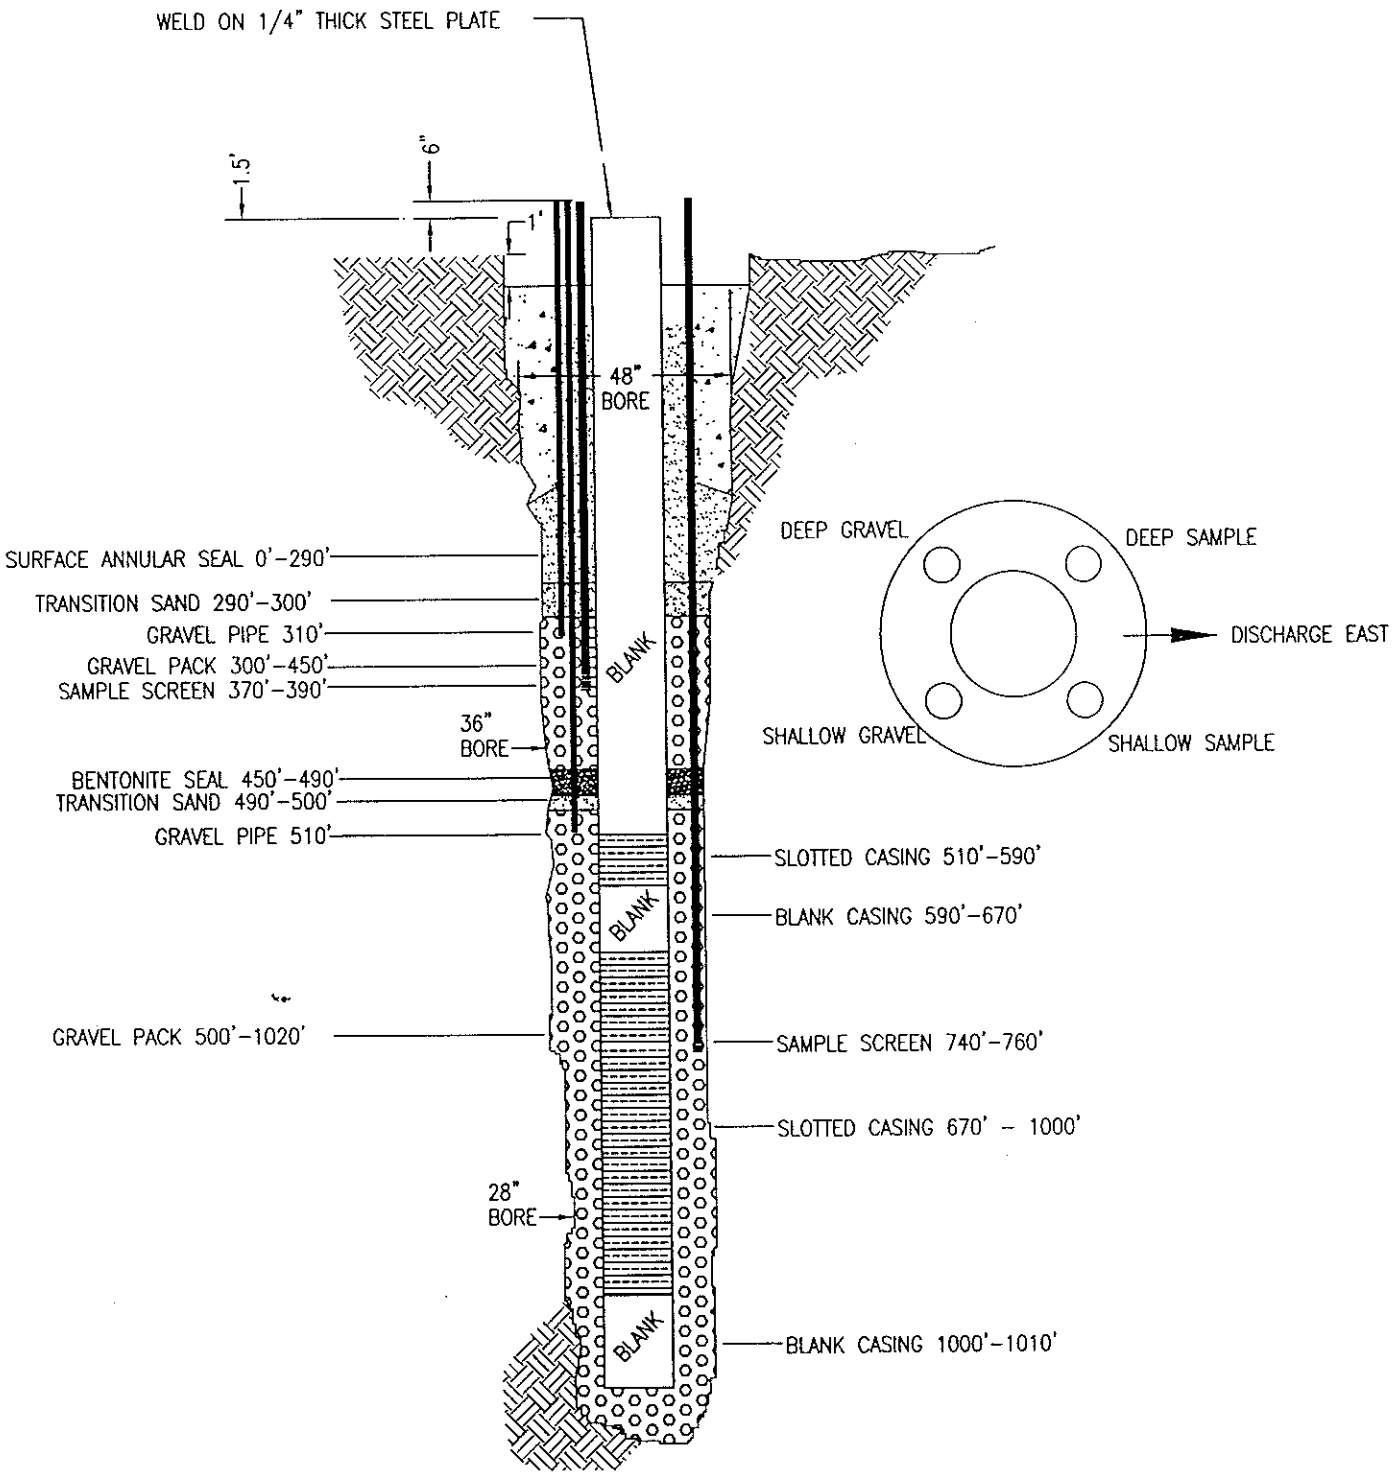
WELD ON 1/4" THICK STEEL PLATE
1.5'
6"
1'
48" BORE
SURFACE ANNULAR SEAL 0'-290'
TRANSITION SAND 290'-300'
GRAVEL PIPE 310'
GRAVEL PACK 300'-450'
SAMPLE SCREEN 370'-390'
BLANK
36" BORE
BENTONITE SEAL 450'-490'
TRANSITION SAND 490'-500'
GRAVEL PIPE 510'
SLOTTED CASING 510'-590'
BLANK
BLANK CASING 590'-670'
GRAVEL PACK 500'-1020'
SAMPLE SCREEN 740'-760'
SLOTTED CASING 670' - 1000'
28" BORE
BLANK
BLANK CASING 1000'-1010'
DEEP GRAVEL
DEEP SAMPLE
DISCHARGE EAST
SHALLOW GRAVEL
SHALLOW SAMPLE

EPA WELL # 108